

KANSAS


Cowley

Section 23 Township 31 Range 4E

Well No. 5 Miller

Company Trees Oil

Misc.
NORTH

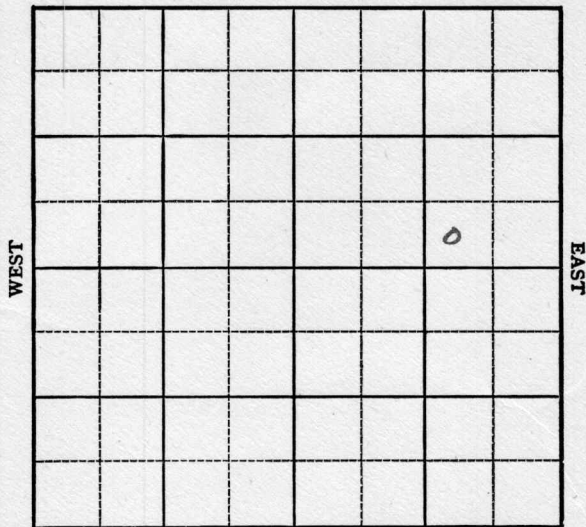

SOUTH

Cowley

KANSAS ✓

Sec. 23 Twp. 31 R. 4E

Well No. #5 Miller Farm

Trees Oil Company

Miscellaneous (Wakefield, Cont.)


_____ Ft. from N. Line

330' Ft. from S. Line

990' Ft. from E. Line

_____ Ft. from W. Line

SW SE NE

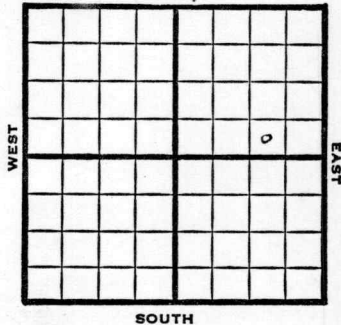

1949

Elev 1231'

REPORT

9/7 8" @ 151'

9/14 Drlg 1800'

9/21 5" @ 2865'
TD 2865'

9/28 "

10/5 "

10/12 TD 2942'
Bart 2870'
Aband.

ABANDONED

Map No. _____ Sec. 23 Twp. 31 R. 4E

Well No. 5 Miller

Trees Oil Company

Wakefield Contractor

SW SE NE

**FIRST REPORT
SECTION PLAT**

_____ Ft. from N. Line

330 Ft. from S. Line

990 Ft. from E. Line

_____ Ft. from W. Line

			o

Cowley County

Location _____

Rig up _____

Drilling and Remarks:

8" @ 151

RECORD

Cased _____ in., _____ ft.

Sand _____

Gas _____

Oil _____

Total Depth _____

PRODUCTION

1st 24 hrs. Nat. _____

1st 24 hrs. after shot _____

Gas _____ Cu. Ft.

Dry Hole _____

Abandoned _____

Date

SEP 7 1949 19

S. J. LEWIS Scout

Map No. _____ Sec. 23 Twp. 31 R. 4E

Well No. 5 Miller

Trees Oil Company

ABANDONED Contractor

SW SE NE

E 1, 1231
SECTION PLAT

_____ Ft. from N. Line

330 Ft. from S. Line

990 Ft. from E. Line

_____ Ft. from W. Line

			o

Cowley County

Location _____

Rig up _____

Drilling and Remarks:

Bar 2570

RECORD

Cased _____ in., _____ ft.

Sand _____

Gas _____

Oil _____

Total Depth 2942

PRODUCTION

1st 24 hrs. Nat. _____

1st 24 hrs. after shot _____

Gas _____ Cu. Ft.

Dry Hole _____

Abandoned _____

Date

OCT 12 1949

19

S. J. LEWIS

Scout