



*Cowley*

Map No. *155* Sec. *22* Twp. *31* R. *4*


Well No. *1 - King* Farm  
*McCullough et al* Company

*330* Ft. from N. Line

..... Ft. from S. Line

*330* Ft. from E. Line

..... Ft. from W. Line

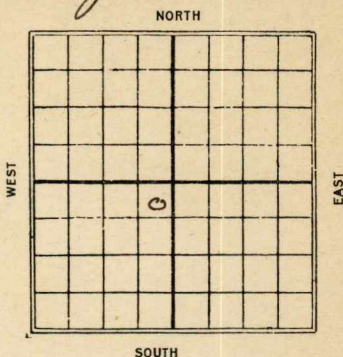

*1926*

Date REPORT

Date	REPORT
<i>12/2</i>	<i>Location</i>
<i>12/8</i>	<i>Bldg rig</i>
<i>12/15</i>	<i>Spudding</i>
<i>12/22</i>	<i>Spudded &amp; S.D.</i>
<i>12/30</i>	<i>Spudding</i>
<i>1927</i>	
<i>1/6</i>	<i>Drilling 300</i>
<i>1/13</i>	<i>" 465</i>
<i>1/19</i>	<i>" 825</i>
<i>1/26</i>	<i>" 950</i>
<i>2/3</i>	<i>" 1500</i>
<i>2/10</i>	<i>UR. 10"-1720</i>
<i>2/17</i>	<i>UR. 10"-1765</i>
<i>2/24</i>	<i>Drlg 1806</i>
<i>3/2</i>	<i>" 2000</i>
<i>3/9</i>	<i>" 2365</i>
<i>3/16</i>	<i>top sand 2424 - pay 2428-32 T.D. 2462 - shot 20 qts. from 2428-37 - 200' oil + 1000' water in hole. Straight-reaming to go deeper -</i>
<i>3/24</i>	<i>UR. 6" - T.D. 2520</i>
<i>3/30</i>	<i>Drlg 2654</i>

4/7 - Topline 3086 - S.D. 3126  
4/13 - Topline 3086 - Small show oil  
3140-45 - Drilling 3155  
4/20 - Drilling 3338 -  
4/27 - Hole full water 3490-96  
Shut down  
5/5 - Show oil 2428-37  
Topline 3086  
small show 3140-45  
H.F.W. 3490-96  
D. & A. 3510

Cowley

2 **KANSAS** Map No. \_\_\_\_\_ Sec. 22 Twp. 31 R. 4

Well No. 1 King \_\_\_\_\_

Mc Cullough et al \_\_\_\_\_ Company

\_\_\_\_\_ Contractor

**FIRST REPORTS**

**SECTION PLAT**

330 \_\_\_\_\_ Ft. from N. Line

\_\_\_\_\_ Ft. from S. Line

330 \_\_\_\_\_ Ft. from E. Line

\_\_\_\_\_ Ft. from W. Line

	o		

Location  \_\_\_\_\_

Rig up \_\_\_\_\_

Drilling and Remarks:

**RECORD**

Cased \_\_\_\_\_ in., \_\_\_\_\_ ft.

Sand \_\_\_\_\_

Gas \_\_\_\_\_

Oil \_\_\_\_\_

Total Depth \_\_\_\_\_

**PRODUCTION**

1st 24 hrs. Nat. \_\_\_\_\_

1st 24 hrs. after shot \_\_\_\_\_

Gas \_\_\_\_\_ Cu. Ft.

Dry Hole \_\_\_\_\_

Abandoned \_\_\_\_\_

Date

DEC 2 1926 **CHAS. L. SHERWOOD**

192

Scout

*Cowley*

Map No. 2 **KANSAS** Sec. 22 Twp. 31 R. 4

Well No. 1 King  
Mc Cullough et al Company

Contractor

**COMPLETED**

**SECTION PLAT**

330 Ft. from N. Line

\_\_\_\_\_ Ft. from S. Line

330 Ft. from E. Line

\_\_\_\_\_ Ft. from W. Line

	0		

**ABANDONED**

Location \_\_\_\_\_

Rig up \_\_\_\_\_

Drilling and Remarks:

*Show del 2428-37  
top line 3086  
small show 3140-45  
AFW 3490-96  
DQH 3510*

**RECORD**

Cased \_\_\_\_\_ in., \_\_\_\_\_ ft.

Sand \_\_\_\_\_

Gas \_\_\_\_\_

Oil \_\_\_\_\_

Total Depth 2510

**PRODUCTION**

1st 24 hrs. Nat. \_\_\_\_\_

1st 24 hrs. after shot \_\_\_\_\_

Gas \_\_\_\_\_ Cu. Ft.

Dry Hole

Abandoned

Date

**MAY 5 1927**

192

**CHAS. L. SHERWOOD**

Scout

MAP NO. K2 **KANSAS** SEC. 52 TWP. 31S R. 4E

WELL NO. 1 Key

M. Cullough COMPANY

CONTRACTOR

**SECTION PLAT**

**ABANDONED**

\_\_\_\_\_ FT. FROM N. LINE

\_\_\_\_\_ FT. FROM S. LINE

\_\_\_\_\_ FT. FROM E. LINE

\_\_\_\_\_ FT. FROM W. LINE

		o	

LOCATION \_\_\_\_\_

RIG UP \_\_\_\_\_

DRILLING AND REMARKS:

**RECORD**

CASED \_\_\_\_\_ IN., \_\_\_\_\_ FT.

SAND \_\_\_\_\_

GAS \_\_\_\_\_

OIL \_\_\_\_\_

TOTAL DEPTH 3510

**PRODUCTION**

1ST 24 HRS. NAT. \_\_\_\_\_

1ST 24 HRS. AFTER SHOT \_\_\_\_\_

GAS \_\_\_\_\_ CU. FT.

DRY HOLE —

ABANDONED —

DATE 5/11 1927 SCOUT