


Company NCRA

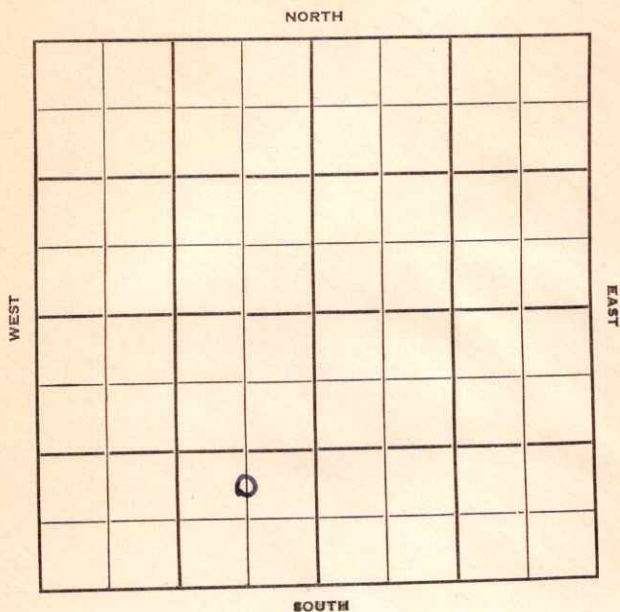

Barton

KANSAS

Sec. 12 Twp. 18 R. 11W

Well No. #7 Roesler Farm

N C R A

Company

Murfin Drlg.

Contractor

Ft. from N. Line


NORTH

990 Ft. from S. Line

660 Ft. from E. Line

Ft. from W. Line

C N L SE SW

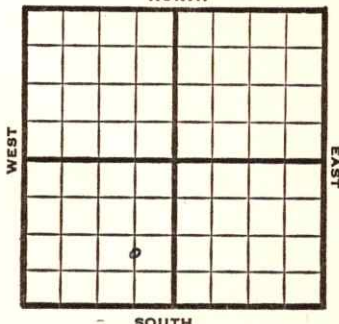

1952

Elev. 1787' REPORT

10/1

Spud 9-26-52
8" @ 235 Anhy 575
Drlg. 1760

10/8

Toronto 2897, Br. L. 2990, Lans
3006, BKC 3250
Fishing 3288'

10/15

Arb 3290
RTD 3292
Drlg. deeper to 3293, B/84 go 2 hrs.

10/22

Spud 9-26-52
Oil Well
TD 3292 1/2
8" @ 235
Anhy 575, Tor 2897', Br. Lim 2990',
Lans. 3006', B KC 3250', Arb 3290
TD 3292
5" @ 3291, CO to 3292 B/40 goph
DD 3292 1/2 B/84 go 2 hr.
Comp. 2126 bopd

COMPLETED

County Barton State KansasSec. 12 (Blk. Twp.) 18 (Sur. Rge.) 11W Map No.Operator N C R AWell No. 7 Farm RoeslerElev. Location C N L SE SW

FIRST REPORT

0

990 Ft. From S Line SW660 Ft. From E Line Quarter1st. Report OCT 1 1952Completion .

Remarks

Murfin Drlg. - Contr.Spudding Date 9-26-52

Drlg. Data

8" @ 235 Anhy 575 drlg. 1760

J. G. McGEHEE

County Barton State Kansas
 Sec. 12 (Blk.) 18 (Sur.) 11W Map No.
 Operator N C R A
 Well No. 7 Farm Roesler
 Elev. 1787 Location C N L SE SW



990 Ft. From S Line SW
660 Ft. From E Line Quarter

1st. Report

Completion OCT 22 1952

Remarks

Murfin Drlg. - Contr.

Spudding Date 9-26-52

Drlg. Data Oil well TD 3292 $\frac{1}{2}$

8" @ 235 Anhy 575 Tor. 2897

Br. lime 2990 Lans. 3006 B KC 3250

Arb. 3290 TD 3292 5" @ 3291 CO to 3292

B/ 40 goph DD 3292 $\frac{1}{2}$ B/ 84 go 2 hr.

Comp. 2126 bopd

J. G. McGEHEE