


Section 23 Township 31 Range 4E

Well No. #6 Miller

Company Trees Oil

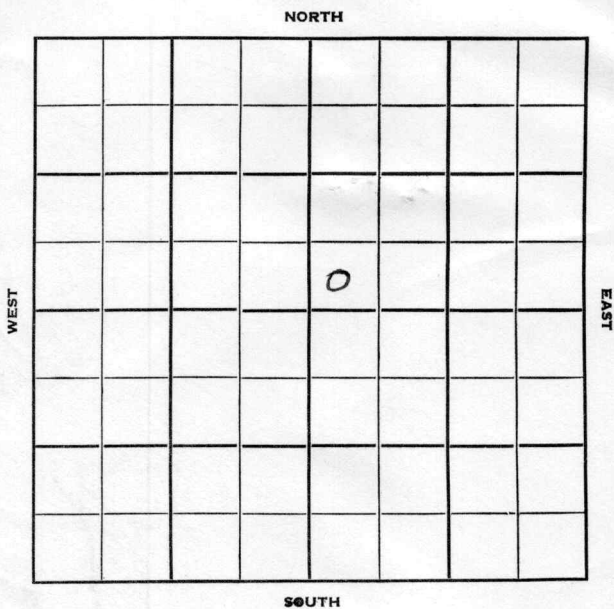

Cowley

KANSAS

Sec. 23 Twp. 31 R. 4E

Well No. #~~5~~ 6 Miller Farm

Trees Oil Company

Watson - Contr. Contractor


_____ Ft. from N. Line

330' Ft. from S. Line

_____ Ft. from E. Line

330' Ft. from W. Line

SW SW NE

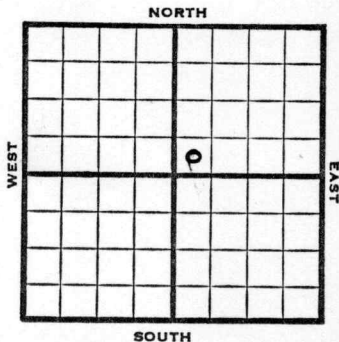

1952

Elev. 1227' REPORT

7/2

8" @ 116'

8/20

Oil Well TD 2950
 8" @ 116 Bart 2899
 TD 2905 5" @ 2901
 DD 2912 KC 2350 DD 2950
 PB 2912 4 Hydro S/5 boph
 Comp. 20 bopd

COMPLETED

Map No. _____ Sec. 23 Twp. 31 R. 4E

Well No. 6 Miller

Trees Oil

Company

CORRECTION

Contractor

SW SW NE

SECTION PLAT

_____ Ft. from N. Line

330 Ft. from S. Line

_____ Ft. from E. Line

330 Ft. from W. Line

		0	

Cowley County

Location _____

Rig up _____

Drilling and Remarks:

Reported
#5 Miller

RECORD

Cased _____ in., _____ ft.

Sand _____

Gas _____

Oil _____

Total Depth _____

PRODUCTION

1st 24 hrs. Nat. _____

1st 24 hrs. after shot _____

Gas _____ Cu. Ft.

Dry Hole _____

Abandoned _____

Date

Aug 20 1952

19

J. G. McGEHEE

Scout

