


Section 13 Township 18 Range 11 WWell No. # 2 Roesler "A"Company Branine & Holl

NORTH

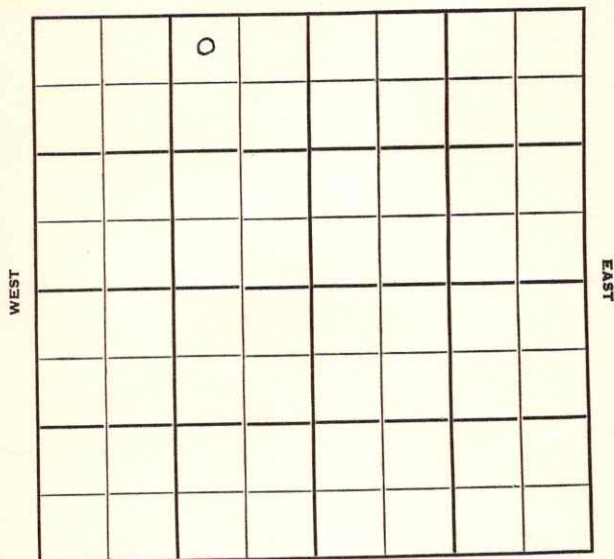

SOUTH

Barton
18

KANSAS

Sec. 13 Twp. 18 R. 11W

Well No. #2 Roesler "A" Farm

Branine & Holl Company

Contractor


330' Ft. from N. Line

Ft. from S. Line

990' Ft. from E. Line

Ft. from W. Line

NW NE NW

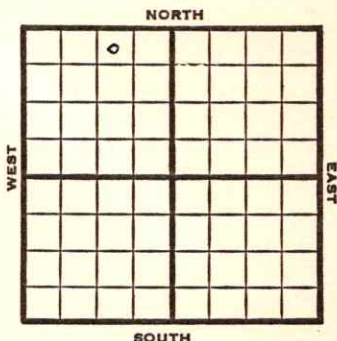

1951

REPORT

Elev. 1782'

4/11 RUR

7/3 Spud 4-10-51
Oil well TD 3289' 8" @ 251'
Anhy 590' Heeb 2870' Br. line 2985'
Lans. 2999' Arb. 3286-89'
5" @ 3286' TD 3289' FU 400' in 45
min. S/18 BOPH
Comp. 1896 BOPD

COMPLETED

County **Barton** State **Kansas**Sec. **13** (Blk. Twp.) **18** (Sur. Rge.) **11W** Map No.Operator **Branine & Holl**Well No. **2** Farm **Roesler "A"**Elev. Location **NW NE NW**

330 Ft. From **N** Line **NW****990** Ft. From **E** Line Quarter1st. Report **APR 11 1951**

Completion

Remarks

Spudding Date

Drlg. Data

RUR

J. E. TYRA

County Barton State Kansas
 Sec. 13 (Bk.) 18 (Sur.) 11W Map No.
 Operator Branine & Holl
 Well No. 2 Farm Roesler "A"
 Elev. 1782 Location NW NE NW

	0				

330 Ft. From N Line NW

990 Ft. From E Line Quarter

1st. Report

Completion JUL 3 1951

Remarks

Spudding Date 4-10-51

Drlg. Data Oil well TD 3289
 8" @ 251 Anhy 590 Heeb. 2870
 Br. lime 2985 Lans. 2999 Arb. 3286-89
 5" @ 3286 TD 3289 FU 400' in 45 min.
 S/ 18 boph Comp. 1896 bopd

J. E. TYRA