Barton KANSAS


DX 78-1

Section 2 Township 18 Range 14W

Well No. 1 Spires

Company Thunderbird Drlg.

10

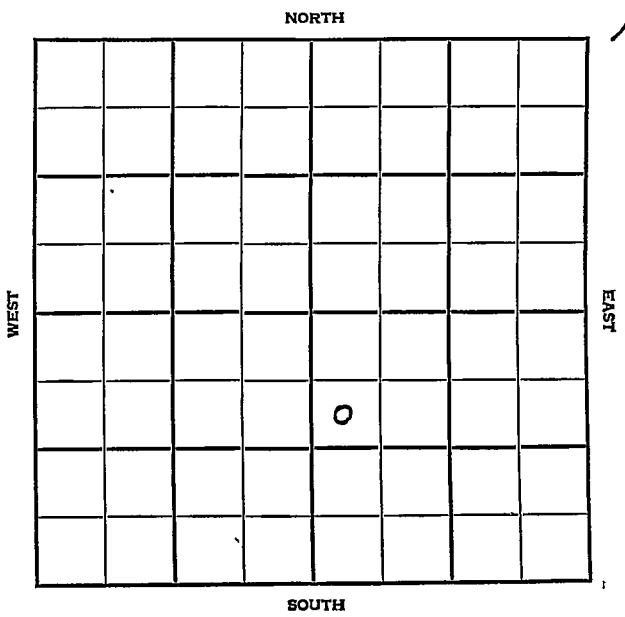

Barton KANSAS

SEC.	TWP.	R.
2	18	14W

WELL NO. 1 Spires FARM

COMPANY Thunderbird Drlg.

CONTRACTOR Co. tools


Boyd Pool

990 Ft. from N. Line

Ft. from S. Line

Ft. from E. Line

330 Ft. from W. Line

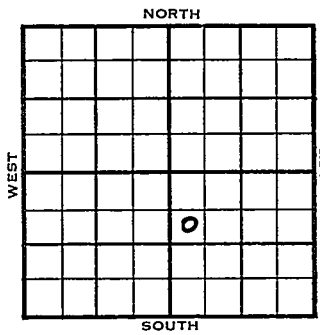

SW NW SE

1954	ELEVATION 1860	REPORT
7/21	Spdg 7-19-54 Drlg. @ 635	
8-11	Spdg 7-19-54 D&A TD 3400 Anhy 810 8" @ 815 Heeb 3036 Br.lime 3110 Lans. 3123 DST 3187-97 open ½ hr. Rec. 20' mud 190# Arb. 3341 DST 3346-49 open ½ hr. Rec. 9' mud 0# DST 3347-53 open 20 min. Rec 10' mud 300# DST 3342-63 open 1hr. Rec. 62' ocm 640# TD 3400 5" @ 3398 CO 12/ 3351/54 100-M-A 500 A HFW 17/ 3344-48 500 A wtr. D&A	

ABANDONED

DX-78

FORM 275 FOR SALE BY KANSAS BLUE PRINT CO.


County Barton State Kansas

Sec. 2 (Blk. Twp.) 18 (Sur. Rge.) 14W Map No.

Operator Thunderbird Drlg.

Well No. 1 Farm Spires

Elev. 1860 Location SW NW SE

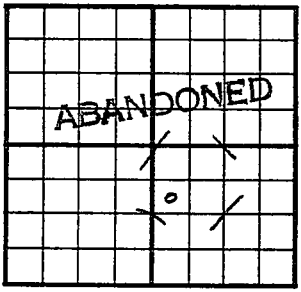

990 Ft. From N Line SE

330 Ft. From W Line Quarter

1st. Report

Completion AUG 11 1954

Remarks Boyd Pool Co. tools

Spudding Date 7-19-54

Drlg. Data D & A TD 3400

Anhy 810 8" @ 815 Heeb. 3036

Br. lime 3110 Lans. 3123 DST 3187-97

open ½ hr. Rec. 20' mud 190# Arb. 3341

DST 3346-49 open ½ hr. Rec. 9' mud 0#

DST 3347-53 open 20 min. Rec. 10' mud 300# DST 3342-63 open 1 hr. Rec. 62' ocm 640# TD 3400 5" @ 3398 CO

12/ 3351-54 100 M-A 500 A HFW

17/ 3344-48 500 A wtr.

D & A

78

FORM 275 FOR SALE BY KANSAS BLUE PRINT CO.


County Barton State Kansas

Sec. 2 (Blk. / Twp.) 18 (Sur. / Rge.) 14W Map No.

Operator Thunderbird Drlg.

Well No. 1 Farm Spires

Elev. Location SW NW SE

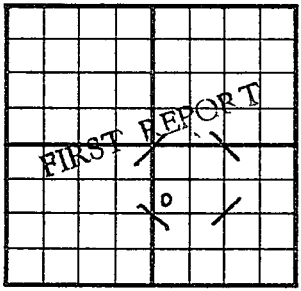

990 Ft. From N Line SE

330 Ft. From W Line Quarter

1st. Report JUL 21 1954

Completion

Remarks

Co. tools

Spudding Date 7-19-54

Drlg. Data Boyd Pool

drlg. @ 635

J. G. McGEHEE