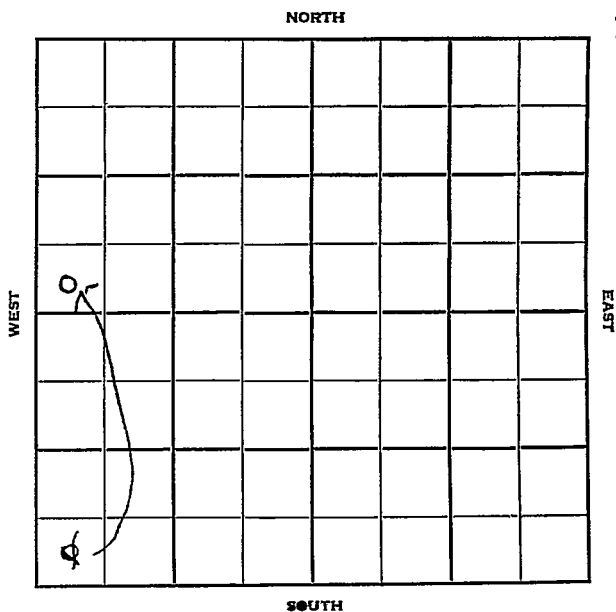


Section 3 Township 17/8 Range 14-WWell No. #1 EveleighCompany Harms & Knight

Barton

KANSAS

Sec. 3 Twp. 17 18 R. 14W ✓

Well No. #1 Eveleigh Farm

Harms & Knight Company

Wildcat Contractor


Ft. from N. Line

330' Ft. from S. Line

Ft. from E. Line

330' Ft. from W. Line

SW SW ^{NW} SW

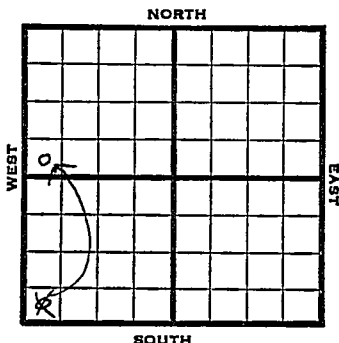

1950

Elev. 1901 REPORT

12/27

Drlg.

1951

2/14

Oil Well TD 3370
Heeb. 3067' Br Lime 3139'
Lans. 3147' Cong. 3351'
Arb. 3368-70
5" @ 3368
TD 3371 6 boph Comp. 77 bopd
3% wtr.

ABANDONED

Kansas

Map No. _____ Sec. 3 Twp. 17 R. 14WWell No. 1 Eveleigh

_____ Harms & Knight _____ Company

_____ CORRECTION _____ Contractor

SW SW NW

SECTION PLAT

_____ Ft. from N. Line

330 Ft. from S. Line

_____ Ft. from E. Line

330 Ft. from W. Line

o			

Barton County

Location _____

Rig up _____

Drilling and Remarks:

Reported

SW SW SW

RECORD

Cased _____ in., _____ ft.

Sand _____

Gas _____

Oil _____

Total Depth _____

PRODUCTION

1st 24 hrs. Nat. _____

1st 24 hrs. after shot _____


Gas _____ Cu. Ft.

Dry Hole _____

Abandoned _____

Date

DEC 27 1950 19 J. E. TYRA Scout

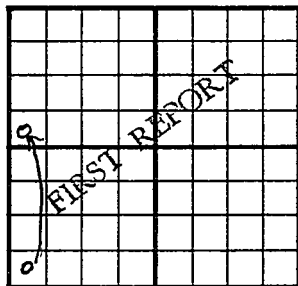County Barton State KansasSec. 3 (Blk. Twp.) 17 (Sur. Rge.) 14W Map No.Operator Harms & KnightWell No. 1 Farm EveleighElev. Location SW SW SW330 Ft. From S Line SW330 Ft. From W Line Quarter1st. Report DEC 27 1950

Completion

Remarks

Spudding Date

Drlg. Data Wildcatdrlg.*see
correction
ticket*

118883

Map No. _____ Sec. 3 Twp. 18 R. 14WWell No. 1 Eveleigh

_____ Harms & Knight _____ Company

_____ CORRECTION _____ Contractor

SW SW NW

SECTION PLAT

_____ Ft. from N. Line

330 Ft. from S. Line

_____ Ft. from E. Line

330 Ft. from W. Line

0			

Barton County

Location _____

Rig up _____

Drilling and Remarks:

Reported

3-17-14W

RECORD

Cased _____ in., _____ ft.

Sand _____

Gas _____

Oil _____

Total Depth _____

PRODUCTION

1st 24 hrs. Nat. _____

1st 24 hrs. after shot _____

Gas _____ Cu. Ft.


Dry Hole _____

Abandoned _____

Date

JAN 17 1951J. E. TYRA Scout

County Barton State Kansas
 Sec. 3 (Blk.) 18 (Sur.) 14W Map No.
 (Twp.) (Rge.)
 Operator Harms & Knight
 Well No. 1 Farm Eveleigh
 Elev. 1901 Location SW SW NW

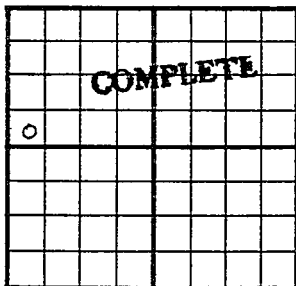

330 Ft. From S Line NW
330 Ft. From W Line Quarter

1st. Report

Completion FEB 14 1951

Remarks Boyd Pool

Spudding Date

Drig. Data Oil well TD 3370

Heeb. 3067 Br. lime 3139 Lans. 3147

Cong. 3351 Arb. 3368-70 5" @ 3368

TD 3371 6 boph Comp. 77 bopd 3% water

J. E. TYRA