

Barton

DX 78-1


KANSAS

Section 36 Township 20 Range 12W

Well No. #8 Dannebohm

Company Petroleum Inc.

NORTH

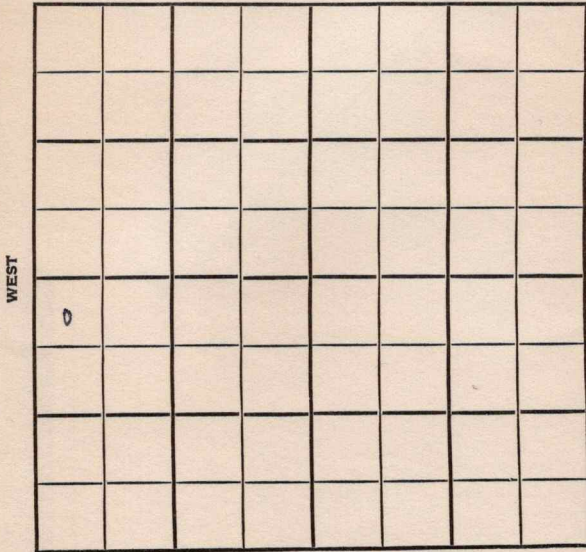

SOUTH

WEST

EAST

Barton KANSAS

SEC.	TWP.	R.
36	20	12W

WELL NO.

8 Dannebohm

FARM

COMPANY

Petr., Inc.

CONTRACTOR

Co. Tools


Chase-Silica Pool

330 _____ Ft. from N. Line

_____ Ft. from S. Line

_____ Ft. from E. Line

330 _____ Ft. from W. Line

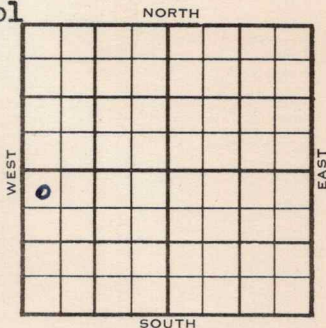

NW NW SW

	ELEVATION	REPORT
1954	1830'	

11/23

Spud 11-21-54
8" @ 252', WOC

1955
1/5

Spud 11-21-54 - Oil Well
TD 3440'
8" @ 252'
Anhy 589', Heeb. 3014', Br lime
3146', L ans 3159', Simp. 3380', Arb.
3387'
DST 3388-99', opn 1 hr., rec. 1740'
gas, 500' free oil, 850#
TD 3440'
4" @ 3438'
CO, 21/3387-97, 500A
S/5½ boph
C omp. 25 bopd

COMPLETED

County Barton State KANSAS

Sec. 36 (Blk. 20 (Sur. 12W Map No.)
(Twp.) (Rge.)

Operator Petroleum Inc.

Well No. 8 Farm Dannebohm

Elev. 1830 Location NW NW SW

330 Ft. From N Line SW

330 Ft. From W Line Quarter

1st. Report

Completion JAN 5 1955

Remarks Chase-Silica Pool

Co. tools

Spudding Date 11-21-54

Drlg. Data Oil well TD 3440

8" @ 252 Anhy 589 Heeb. 3014

Br. lime 3146 Lans. 3159 Simp. 3380

Arb. 3387 DST 3388-99 open 1 hr.

Rec. 1740' gas 500' free oil 850#

TD 3440 4" @ 3438 CO 21/ 3387-97

500 A S/ 5 $\frac{1}{2}$ boph Comp. 25 bopd

COMPLETE

FABEN GILSTRAP