


DX 78-1 Barton

KANSAS

Section 36 Township 20S Range 12W

Well No. #1 Kowalsky

Company Petroleum Inc.

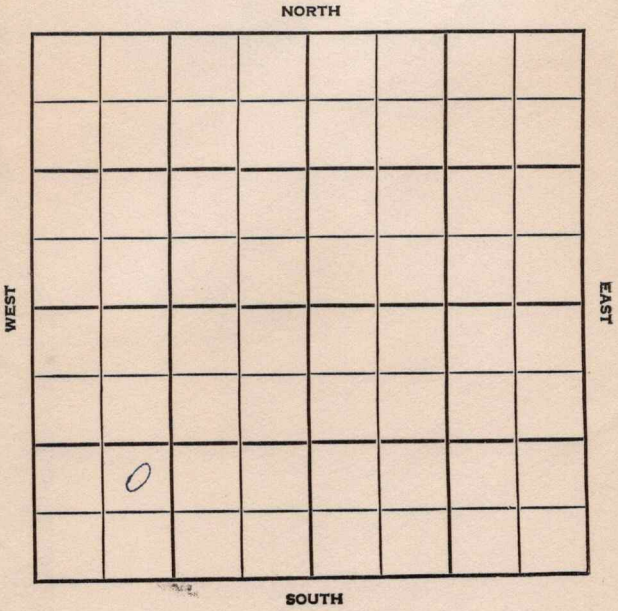

Barton

KANSAS

SEC.

36

TWP.

20S

R.

12W

WELL NO.

#1 Kowalsky (SWDW)

FARM

COMPANY

Petroleum, Inc.

CONTRACTOR

Garvey #9

Chase-Silica So.


____ FT. FROM N. LINE

____ FT. FROM S. LINE

____ FT. FROM E. LINE

____ FT. FROM W. LINE

NE SW SW

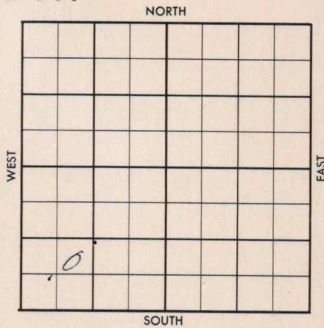

1956

ELEVATION

1822'

REPORT

8-1

Comm. 7-27-56

8" @ 588

Drlg. 1820'

8-22

5½" @ 3702

DD 3800

3000 acid

Comp. for SWD Well

H. 3001'; Tr. 3015'; BL. 3133';

L. 3146'; S. 3381'; A. 3385';

TD 3704'

ABANDONED

County Barton Elev. _____
Sec. 36 Twp. 20S Rgs. 12W
Company Petroleum, Inc.
Farm Name Kowalsky No. 1

TOPS	DEPTH	LOG	DATUM
Anh.			
TP.			
H.			
Tr.			
Dg.			
BL.			
L.			
K.C.			
B.K.C.			
Ce.			
C.			
M.			
M.			
K.			
Mz.			
Me.			
V.			
S.			
S.			
A.			
R.			
PE.			
G.			
T.D.			

SWDW
Loc. in Sec. NE SW SW

Geol. _____
Contr. Garvey #9

Pool Chase-Silica So.

FIRST REPORT

Date Comm. AUG 1 1956
7-27-56; 8" 588; D 1820

13

3281 AUG 5 1956

R. G. R.

County Barton Elev. 1822
 Sec. 36 Twp. 20S Rge. 12W
 Company Petroleum, Inc.
 Farm Name Kowalsky No. 1

SWDW

TOPS	DEPTH	LOG	DATUM	Loc. in Sec.
Anh.				NE SW SW
TP.				
H.	3001			
Tr.	3015			
Dg.				
BL.	3133			
L.	3146			
K.C.				Geol.
B.K.C.				Contr.
Ce.				Garvey #9
C.				Pool
M.				Chase-Silica So.
K.				
Mz.				
Me.				
V.				
S.	3387			
S.				
A.	3385			
R.				
Pe.				
G.				
TD	3704			

ABANDONED

Date Comm.

AUG 22 1956

7-27-56; 8" 588; D 1820 AUG 8 '56 5 1/2

3702 / AUG 15 '56 W O C T AUG 22 '56

CO DD 3800 TD 3000 acid
comp. for SWD Well.