

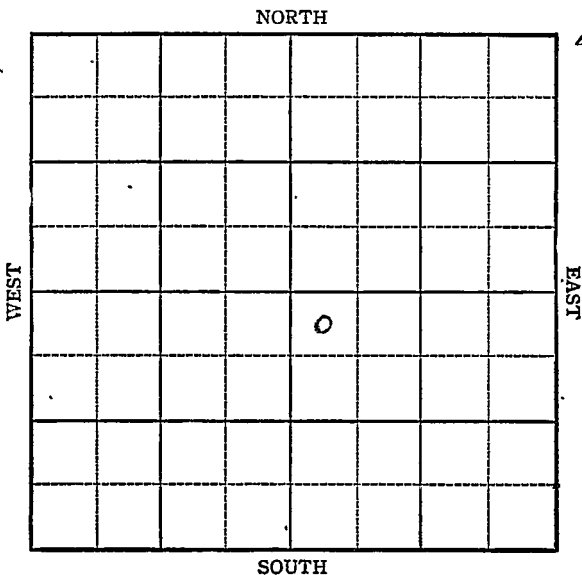
KANSAS

Barton

Section 3 Township 18 Range 14W

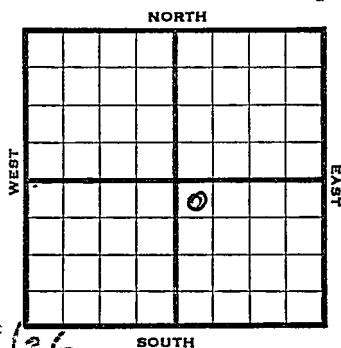
Well No. #1 Eveleigh

Company Imo Oil



Sec. 3 Twp. 18 R. 14WWell No. #1 Eveleigh FarmImo Oil Company330 Ft. from N. Line Ft. from S. Line Ft. from E. Line330 Ft. from W. Line

NW SE

E Dec. 1866

1945

R E P O R T

1/24 Location

1/31 8" @ 844'
Drlg. 850'2/7 Drlg 2717
Anhy 834

2/14 TD 3341 5" @ 3339 RUST

2/21 Arb. 3339
TD 3341 RUST

2/28 " " "

3/7 TD 3353 $\frac{1}{2}$ 2100' oil in 13 hrs

3/14 " " " " " " "

3/23 " " " " " " "

3/29 " " " " " " "

4/5 " " " " " " "

4/11 Arb 3339

5" @ 3339

TD 3353 $\frac{1}{2}$

Pump 158 Pot.

Grav. 39.3

COMPLETED

Pool Name BoyerMap No. 73 Sec. 3 Twp. 18 R. 14WWell No. 1 Eveleigh

Imo Oil

Company

FIRST REPORT

Contractor

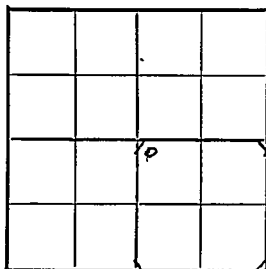
NW SE

SECTION PLAT

330 Ft. from N. Line

Ft. from S. Line

Ft. from E. Line

330 Ft. from W. Line

Barton

Location X

Rig up

Drilling and Remarks:

RECORD

Cased _____ in., _____ ft.

Sand _____

Gas _____

Oil _____

Total Depth _____

PRODUCTION

1st 24 hrs. Nat. _____

1st 24 hrs. after shot _____

Gas _____ Cu. Ft.

Dry Hole _____

Abandoned _____

Date

JAN 24 1945

19

S. J. LEWIS Scout

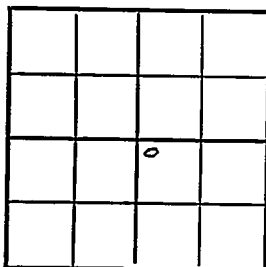
Kansas

Pool Name BoydMap No. 73 Sec. 3 Twp. 18 R. 14WWell No. 1 EveleighImo Oil Company**COMPLETED**

Contractor

NW SE

SECTION PLAT

330 Ft. from N. Line Ft. from S. Line Ft. from E. Line330 Ft. from W. LineBartonElev 1866Location Rig up

Drilling and Remarks:

Cor 433395" C3339Pump 108 BT39 3/4

RECORD

Cased in, ft.Sand Gas Oil Total Depth 3352 1/2

PRODUCTION

1st 24 hrs. Nat. 1st 24 hrs. after shot Gas Cu. Ft.Dry Hole Abandoned

Date

APR 11 194519S. J. LEWISScout