

FORM 51 5M BRIX

**KANSAS**Section 3 Township 18 Range 14WWell No. #1 EvelieghCompany Branine & Goering

|  |  |  |  |  |  |  |  |
|--|--|--|--|--|--|--|--|
|  |  |  |  |  |  |  |  |
|  |  |  |  |  |  |  |  |
NORTH

WEST

EAST

SOUTH

5

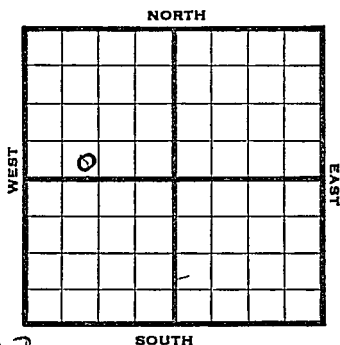
0

KANSAS

Sec. 3 Twp. 18 R. 14WWell No. #1 Eveligh Farm

Branine &amp; Goering Company

Boyd

       Ft. from N. Line330 Ft. from S. Line       Ft. from E. Line990 Ft. from W. LineSE SW NW E.L. 1907

| 1944        | R E P O R T                                                                   |
|-------------|-------------------------------------------------------------------------------|
| 12/6        | 8" @ 871'<br>Drlg. 2045'                                                      |
| 12/14       | Anhy 855<br>Lans 3114<br>Cong 3364<br>Arb. 3374<br>TD 3375<br>5" @ 3375' RUST |
| 12/21       | " " " "                                                                       |
| 12/29n      | TD 3398<br>8 oil 2 oil PH                                                     |
| 1945<br>1/3 | " " " "                                                                       |
| 1/10        | 250 oil in 3 hrs                                                              |
| 1/17        | " " " " "                                                                     |
| 1/26        | 500 acid Pump 65 oil                                                          |
| 1/31        | " " " " "                                                                     |
| 2/7         | " " " " "                                                                     |
| 2/14        | 1200 acid pump 100 oil in 24 hrs                                              |
| 2/21        | " " " " " "                                                                   |
| 2/28        | " " " " " "                                                                   |
| 3/7         | " " " " " "                                                                   |
| 3/14        | " " " " " "                                                                   |
| 3/23        | " " " " " "                                                                   |
| 3/26        | " " " " " "                                                                   |

OVER

1945

|      |          |      |      |     |     |    |        |
|------|----------|------|------|-----|-----|----|--------|
| 4/5  | 1200     | acid | pump | 100 | oil | in | 24 hrs |
| 4/12 | "        | "    | "    | "   | "   | "  | "      |
| 4/20 | "        | "    | "    | "   | "   | "  | "      |
| 4/27 | "        | "    | "    | "   | "   | "  | "      |
| 5/3  | "        | "    | "    | "   | "   | "  | "      |
| 5/10 | "        | "    | "    | "   | "   | "  | "      |
| 5/17 | "        | "    | "    | "   | "   | "  | "      |
| 5/24 | "        | "    | "    | "   | "   | "  | "      |
| 6/6  | Arb 3374 |      |      |     |     |    |        |

5" @ 3375

1700 acid.

TD 3393'

Pump 76 Pot.

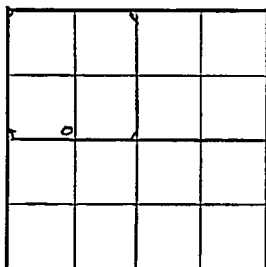
Grav. 38.0

COMPLETED

Pool Name BoydMap No. 73 Sec. 3 Twp. 18 R. 14WWell No. 1 EvelieghBranine & Goering CompanyFIRST REPORT Contractor

SE SW NW

## SECTION PLAT

       Ft. from N. Line330 Ft. from S. Line       Ft. from E. Line990 Ft. from W. LineBartonLocation                     Rig up                     

Drilling and Remarks:

8"-8712045

## RECORD

Cased            in.,            ft.Sand                     Gas                     Oil                     Total Depth                     

## PRODUCTION

1st 24 hrs. Nat.                     1st 24 hrs. after shot                     Gas                      Cu. Ft.Dry Hole                     Abandoned                     

Date

DEC 6 1944 19S. J. LEWIS Scout

Kansas Pool Name BoydMap No. 73 Sec. 3 Twp. 18 R. 14WWell No. 1 EveleighBranine & Goering CompanyCOMPLETE

Contractor

SE SW NW

## SECTION PLAT

|   |  |  |  |
|---|--|--|--|
|   |  |  |  |
|   |  |  |  |
| 6 |  |  |  |
|   |  |  |  |
|   |  |  |  |

       Ft. from N. Line330 Ft. from S. Line       Ft. from E. Line990 Ft. from W. LineBarton CountyLocation       Rig up       

Drilling and Remarks:

OK 33745" casing1700 feetPump 76 ft38-1/2

## RECORD

Cased        in.,        ft.Sand       Gas       Oil       Total Depth 3373

## PRODUCTION

1st 24 hrs. Nat.       1st 24 hrs. after shot       Gas        Cu. Ft.Dry Hole       Abandoned       

Date

JUN 6 1945S. J. LEWIS

Scout