


Section 36 Township 20 Range 12W

Well No. #2 Alexian

Company B & B Drlg.

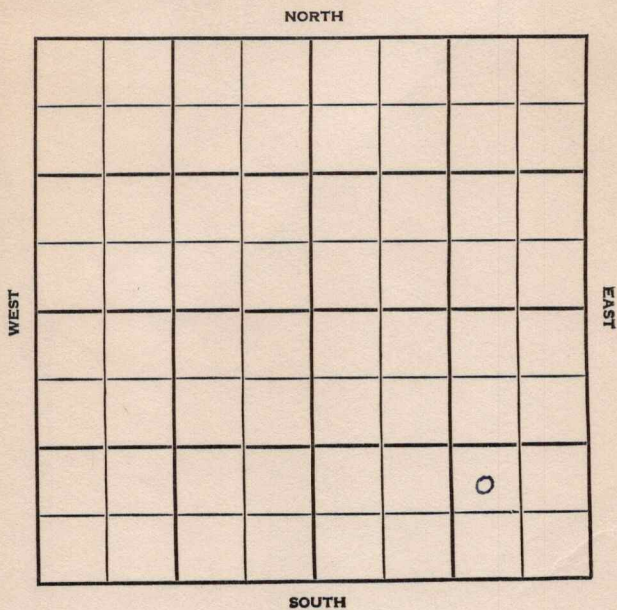

SEC.	TWP.	R.
36	20	12W


WELL NO. #2 Alexian FARM

COMPANY B & B Drlg.

CONTRACTOR Co. Tools.

Kowalsky Pool

\_\_\_\_\_ Ft. from N. Line  
 990 \_\_\_\_\_ Ft. from S. Line  
 990 \_\_\_\_\_ Ft. from E. Line  
 \_\_\_\_\_ Ft. from W. Line

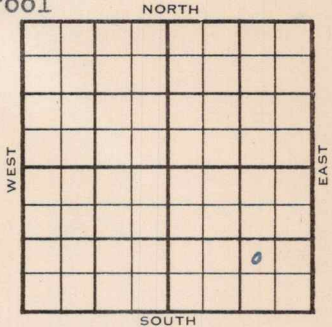

NW SE SE

	ELEVATION	REPORT
1954	1818'	
10/13	Spud 10-6-54 8" @ 250'	Anhy 578', Heeb 3005', Br. Lime 3136' Lans 3149' Drlg. 3210'
10/27	Spud 10-6-54 Oil Well TD 3396' 8" @ 250'	Anhy 578', Heeb 3005', Br. Lime 3136' Lans 3149' DST 3270'-86' opn 20 min, rec 6' Mud Off Simp 3381', Arb 3386' DST 3388'-92' opn 1/2 hr, rec 3000' gas, 150' oil, 430# TD 3392' 5" @ 3389' DD 3396# FU 160' oil 2 hr. 750 A Comp 30 bopd.

COMPLETED



