


Section 3 Township 18 Range 14W

Well No. #2 Evelyigh

Company Branine & Goring

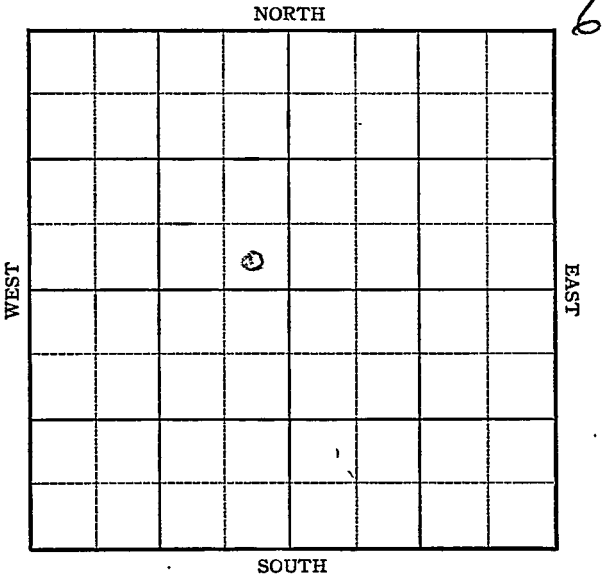

Sec. 3 Twp. 18 R. 14W


Well No. #2 Eveleigh Farm
Branine & Goring Company
Boyd

_____ Ft. from N. Line

330 Ft. from S. Line

330 Ft. from E. Line

_____ Ft. from W. Line

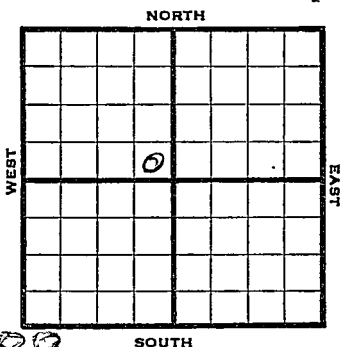

SE NW Eveleigh 1882

1945

R E P O R T

3/7

R U R

3/14

"

3/23

8" @ 866

Drlg. 2140'

3/29

Drlg. 2708

4/5

Drlg. 2910'

4/12

2910' S.D.

4/20

Arb 3356

TD 3359

5" @ 3357' RUST

4/27

" " "

5/3

TD 3377

2500 acid. HFW

PB

5/10

PB 3372 swab 4 oil a day

5/17

" " " " " "

5/24

" " " " " "

5/31

" " " " " "

6/8

" " " " " "

6/27

Arb 3356

5" @ 3357

PB 3372

TD 3377

2500 acid.

Pump 80 oil plus 33 W Pot.

Grav. 36.0

COMPLETED

Pool Name BoydMap No. 73 Sec. 3 Twp. 18 R. 14WWell No. 2 EveleighBranine & Goring CompanyFIRST REPORT Contractor

SE NW

SECTION PLAT

_____ Ft. from N. Line

330 Ft. from S. Line330 Ft. from E. Line

_____ Ft. from W. Line

Barton

Location _____

Rig up _____

Drilling and Remarks:

RUR

RECORD

Cased _____ in., _____ ft.

Sand _____

Gas _____

Oil _____

Total Depth _____

PRODUCTION

1st 24 hrs. Nat. _____

1st 24 hrs. after shot _____

Gas _____ Cu. Ft.

Dry Hole _____

Abandoned _____

Date

MAR 7 1945 19 _____ S. J. LEWIS Scout

