


Section 3 - Township 18 Range 14W

Well No. 3 Eveleigh

Company Branine & Goring

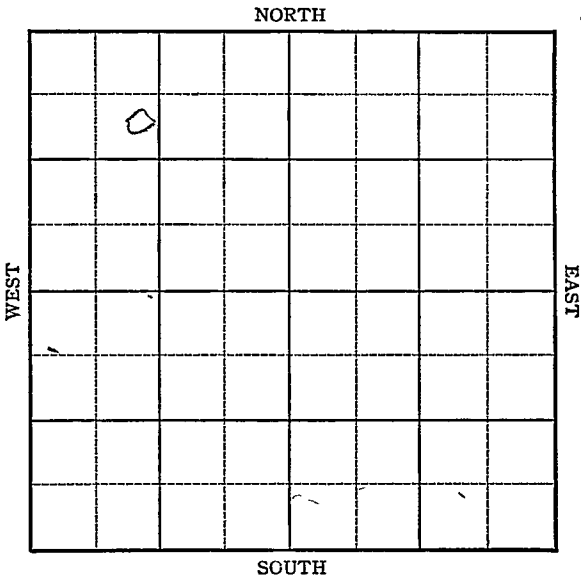

KANSAS

Barton

Sec. 3 Twp. 18 R. 14W

Well No. 3 Eveleigh Farm


Branine & Goring Company

Boyd
990 Ft. from N. Line

_____ Ft. from S. Line

_____ Ft. from E. Line

990 Ft. from W. Line

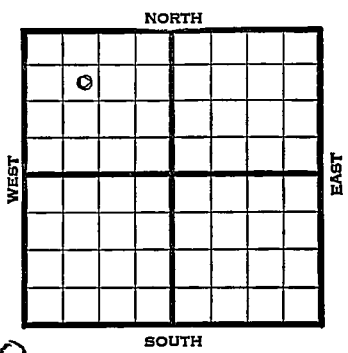

SE NW NW *Leas. 1930*

1945 REPORT

5/29	8" 880 WOC
6/13	Lams 3091
	Arb 3435
	TD 3438'

ABANDONED

Kansas Pool Name Boyd

Map No. 73 Sec. 3 Twp. 18 R. 14W

Well No. 3 Eveleigh

Branine & Goring Company

FIRST REPORT

Contractor

SE NW NW

SECTION PLAT

990 Ft. from N. Line

_____ Ft. from S. Line

_____ Ft. from E. Line

990 Ft. from W. Line

a			.

Barton

Location _____

Rig up _____

Drilling and Remarks:

8"-880 WOC

RECORD

Cased _____ in., _____ ft.

Sand _____

Gas _____

Oil _____

Total Depth _____

PRODUCTION

1st 24 hrs. Nat. _____

1st 24 hrs. after shot _____

Gas: _____ Cu. Ft.

Dry Hole _____

Abandoned _____

Date

MAY 2 9 1945 19 _____

S. J. LEWIS Scout

Kansas Pool Name BoydMap No. 13 Sec. 3 Twp. 18 R. 14WWell No. 3 EveleighBranine & Goring Company**ABANDONED**

Contractor

SE NW NW

SECTION PLAT

990 Ft. from N. Line Ft. from S. Line Ft. from E. Line990 Ft. from W. Line

o			

Barton County

Location _____

Rig up _____

Drilling and Remarks:

Lions 3091Cor 83435

RECORD

Cased _____ in., _____ ft.

Sand _____

Gas _____

Oil _____

Total Depth 3435

PRODUCTION

1st 24 hrs. Nat. _____

1st 24 hrs. after shot _____

Gas _____ Cu. Ft.

Dry Hole _____

Abandoned _____

Date

JUN 1 3 1945 19S. J. LEWIS Scout