


Section 36 Township 20 Range 12W

Well No. 9 Dannebohm

Company Petroleum, Inc.

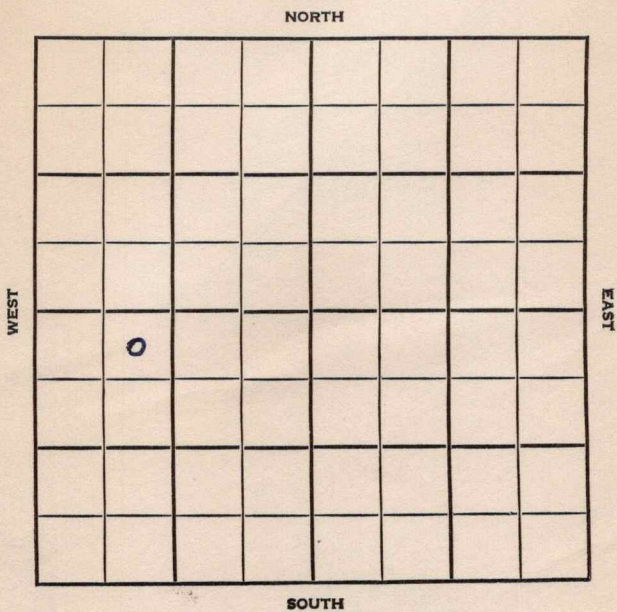

SEC.	TWP.	R.
36	20	12W

WELL NO. #9 Dannebohn FARM

COMPANY Petroleum Inc.

CONTRACTOR Garvey

Kowalsky Pool

330 _____ Ft. from N. Line

_____ Ft. from S. Line

_____ Ft. from E. Line

990 _____ Ft. from W. Line

WEST

NORTH					
	0				
SOUTH					

EAST

NE NW SW

1955	ELEVATION	REPORT
4/20	Spud 4-18-55 8" @ 243'	
7/7	WOC	DST 3401-07, open 1 hr. Rec 30' froggy oil 240' free oil 850/20" TD 3407 5 1/2" @ @ 3402 CO to 3407 4 1/2 bo 4% mud 5 boph Comp. 120 bopd.
	Tops:	Depth Datum
	^nh.	585
	H.	3013 1187
	BL.	3146 1320
	L.	3157 1331
	S.	3392 1566
	A.	3400 1574
	TD.	3407

COMPLETED

County Barton Elev. 1826
 Sec. 36 Twp. 20 Rge. 12W
 Company Petroleum Inc.
 Farm Name Dannebohn No. 9

TOPS	DEPTH	LOG	DATUM	Loc. in Sec.
Anh.	<u>585</u>			NE NW SW
TP.				
H.	<u>3013</u>		<u>1187</u>	
Tr.				
Dg.				
BL.	<u>3146</u>		<u>1320</u>	
L.	<u>3157</u>		<u>1331</u>	Geol.
K.C.				Contr.
B.K.C.				Garvey
Ce.				Pool
C.				Kowalsky
M.				
M.				
K.				
Mz.				
Ma.				
V.				
S.	<u>3392</u>		<u>1566</u>	COMPLETE
S.				
A.	<u>3400</u>		<u>1574</u>	
R.				
PE.				
G.				
TD.	<u>52</u>		<u>1576</u>	
	<u>3407</u>		<u>1581</u>	

Date Comm. 4-18-55 JUL 6 1955
8" @ 243/200 DST 3401-07 open 1 hr.

Rec. 30' froggy oil 240' free oil
850/20" TD 3407 5 1/2" @ 3402
CO to 3407 4 1/2 bo 4% mud 5 boph
Comp. 120 bopd