

Section 36 Township 20 Range 12 W

Well No. # 1 Panning

Company Birmingham & Bartlett

NORTH

	0						

WEST

EAST

SOUTH




Sec. 36 Twp. 20 R. 12 W

Well No. #1 Panning Farm

Birmingham & Bartlett Company

Contractor

330 Ft. from N. Line
 Ft. from S. Line
 Ft. from E. Line
 990 Ft. from W. Line
 NE NW NW

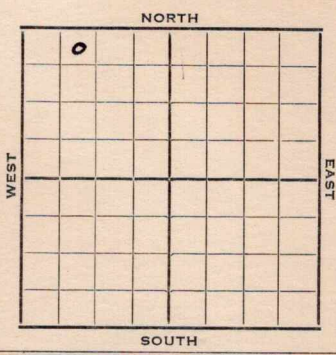

1952

Elev. 1822' REPORT

3/26 Cellar & Pits
 4/1 8" @ 258' WOC
 4/9 Anhy 610 Heeb. 3003 Br Li 3130
 Lans. 3143 Arb. 3367
 RTD 3370 5" @ 3369 WOCT
 4/23 DP DD 3380 TD 5/20 galoph for 5 hrs.
 500 A S/1 BOPH for 6 hrs.
 1500 A POP P/5 BO9 hrs
 Set Pkr 3344
 4/30 DD 3388 250 A to put back on pump
 5/7 NR
 5/14 "
 5/21 "
 5/28 P/4 BOPD
 6/11 P/8 BO 4 hrs.
 6/18 40 qts nitro opn hole P/8 BOPD
 6/25 Spud 3-30-52 Oil Well TD 3388
 8" @ 258 Anhy 610 Heeb. 3003
 Br lime 3130 Lans. 3143
 Arb. 3367 TD 3370
 5" @ 3369 DD 3380 S/20 goph
 500 A S/1 boph 1500 A P/5 bo 9 hr.
 SP 3344 DD 3388 250 A
 P/4 bopd P/8 bo 8 hr. 40 qt. opn hole
 F/8 bopd Comp. 10 bopd

COMPLETED

County **Barton** State **Kansas**

Sec. **36** (Blk. Twp.) **20** (Sur. Rge.) **12W** Map No.

Operator **Birmingham & Bartlett**

Well No. **1** Farm **Panning**

Elev. **1822** Location **NE NW NW**

0			

330 Ft. From **N** Line **NW**

990 Ft. From **W** Line **Quarter**

Ist. Report **MAR 26 1952**

Completion


Remarks

Spudding Date

Drig. Data

Cellar & pits

County Barton State Kansas
 Sec. 36 (Blk. 20) (Sur. 12W) Map No. _____
 Operator Birmingham & Bartlett
 Well No. 1 Farm Panning
 Elev. 1822 Location NE NW NW

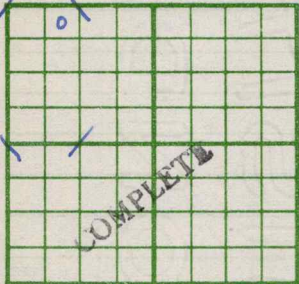

330 Ft. From N Line NW
990 Ft. From W Line Quarter
 Ist. Report _____
 Completion JUN 25 1952
 Remarks _____
 Spudding Date 3-30-52

Drig. Data Oil well TD 3388
8" @ 258 Anhy 610 Heeb. 3003
Br. line 3130 Lans. 3143 Arb. 3367
TD 3370 5" @ 3369 DD 3380 S/ 20 goph
500 A S/ 1 boph 1500 A P/ 5 bo 9 hr.
SP 3344 DD 3388 250 A P/ 4 bopd
P/ 8 bo 8 hr. 40 qt./ open hole
P/ 8 bopd Comp. 10 bopd