


Section 1 Township 20 Range 13 W

Well No. # 1 Rogers

Company Shelly-Miller

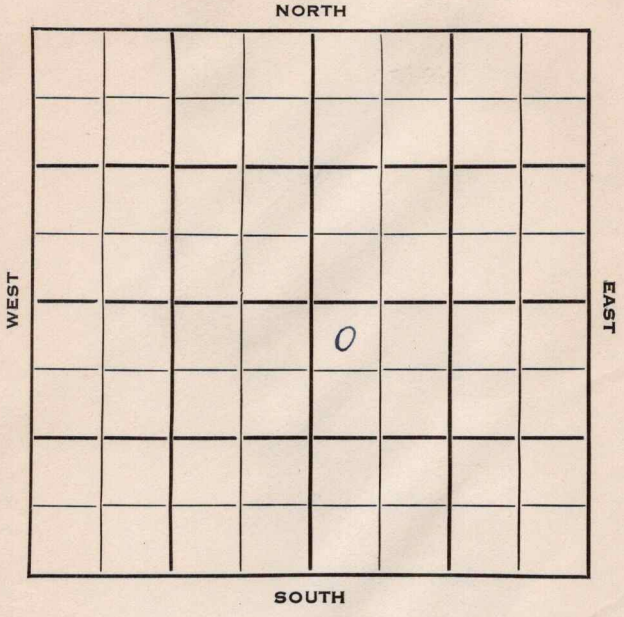

Barton

KANSAS

SEC.	TWP.	R.
1	20	13 W ✓


WELL NO. # 1 Rogers FARM

COMPANY Shelly-Miller

CONTRACTOR Shelly-Miller

Wildcat

330 Ft. from N. Line
 _____ Ft. from S. Line
 _____ Ft. from E. Line
 330 Ft. from W. Line

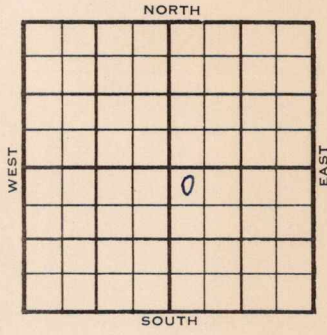

NW NW SE

	ELEVATION	REPORT
1954	1832'	

4/7	Spud 4-1-54 8" @ 135 Drlg. 2750'	
4/14	Spud 4-1-54 D & A TD 3475' 8" @ 135' Heeb 3048', Br. Lime 3164', Lams 3179' DST 3195'-3255' opn 1 hr, rec 30' Mud 640# Cong 3413', Arb 3437' DST 3438'-47' opn 1/2 hr, rec 10' Mud 1275# TD 3475' D & A	

ABANDONED

County Barton State Kansas

Sec. 1 (Blk. 20 (Sur. 13W (Twp.) (Rge.) Map No.

Operator Shelly-Miller

Well No. 1 Farm Rogers

Elev. 1832 Location NW NW SE

330 Ft. From N Line SE

330 Ft. From W Line Quarter

1st. Report APR 7 1954

Completion _____

Remarks _____

Shelly-Miller - Contr.

Spudding Date 4-1-54

Drlg. Data Wildcat

8" @ 135 drlg. 2750

County Barton State Kansas

Sec. 1 (Blk.) 20 (Sur.) 13W Map No. (Twp.)

Operator Shelly-Miller

Well No. 1 Farm Rogers

Elev. 1832 Location NW NW SE

ABANDONED									

330 Ft. From N Line SE

330 Ft. From W Line Quarter

Ist. Report _____

Completion APR 14 1954

Remarks Wildcat

Shelly-Miller - Contr.

Spudding Date 4-1-54

Drlg. Data D & A TD 3475

8" @ 135 Heeb. 3048 Br. lime 3164

Lans. 3179 DST 3195-3255 open 1 hr.

Rec. 30' mud 640# Cong. 3413

Arb. 3437 DST 3438-47 open 1/2 hr.

Rec. 10' mud 1275# TD 3475

D & A

J. G. MCGEHEE