


DX 78-1

Barton

Section 2 Township 20 Range 13 W

Well No. # 1 Carroll

Company Harry Gore

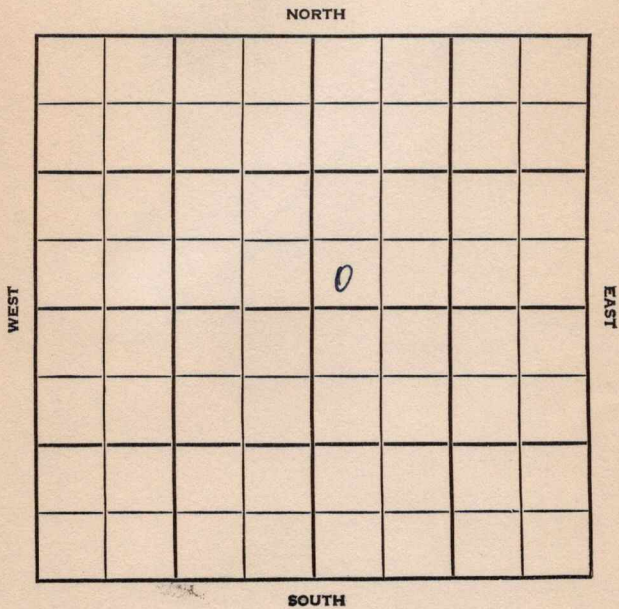

Barton KANSAS		
SEC.	TWP.	R.
2	20	13W
WELL NO.		
1 Carroll		FARM
COMPANY		

CONTRACTOR
Harry Gore


Veeder
Wildcat

_____ Ft. from N. Line

330 _____ Ft. from S. Line

_____ Ft. from E. Line

330 _____ Ft. from W. Line

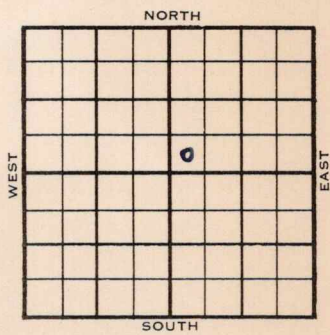

SW SW NE

	ELEVATION	REPORT
1954	1836'	

5/19
6/2

Location
 Spud 5-19-54 D & A TD 3505
 8" @ 213 Anhy 670 Heeb 3063
 Br. lime 3176 Lans. 3190
 DST 3310-29 open 40 min rec 20' mud 640#
 DST 3216-28 open 1/2 hr rec 4' mud 0#
 Cong. 3421
 DST 3412-46 open 1/2 hr. rec 15' mud 290#
 Arb. 3441
 DST 3445- 80 open 1 hr rec 90' mud 570#
 DST 3480-3505 open 1 hr rec 420' SW 1000#
 TD 3505' D & A

ABANDONED

County Barton State Kansas
Sec. 2 (Blk. 20 (Sur. 13W Map No.

Operator Harry Gore

Well No. 1 Farm Carroll

Elev. Location SW SW NE

330 Ft. From S Line NE

330 Ft. From W Line Quarter

Ist. Report MAY 19 1954

Completion

Remarks


Veeder - Contr.

Spudding Date

Drlg. Data Wildcat

Location

County Barton State Kansas
 Sec. 2 (Blk.) 20 (Sur.) 13W Map No. _____
 Operator Harry Gore
 Well No. 1 Farm Carroll
 Elev. 1836 Location SW SW NE

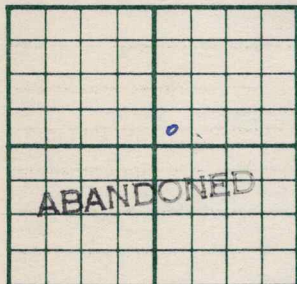

330 Ft. From S Line NE
330 Ft. From W Line Quarter

1st. Report _____

Completion JUN 2 1954

Remarks Wildcat

Veeder - Contr.

Spudding Date 5-19-54

Drlg. Data D & A TD 3505

8" @ 213 Anhy 670 Heeb. 3063

Br. lime 3176 Lans. 3190 DST 3310-29

open 40 min. Rec. 20' mud 640#

DST 3216-28 open $\frac{1}{2}$ hr. Rec. 4' mud

0# Cong. 3421 DST 3412-46 open $\frac{1}{2}$ hr.

Rec. 15' mud 290# Arb. 3441 DST 3445-

80 open 1 hr. Rec. 90' mud 570#

DST 3480-3505 open 1 hr. Rec. 420' sw

1000 # TD 3505

D & A

J. G. McGEHEE