DX 78-1


Barton

KANSAS

Section 4 Township 20 Range 13 W

Well No. #1 Service Oil

Company Petroleum Inc.

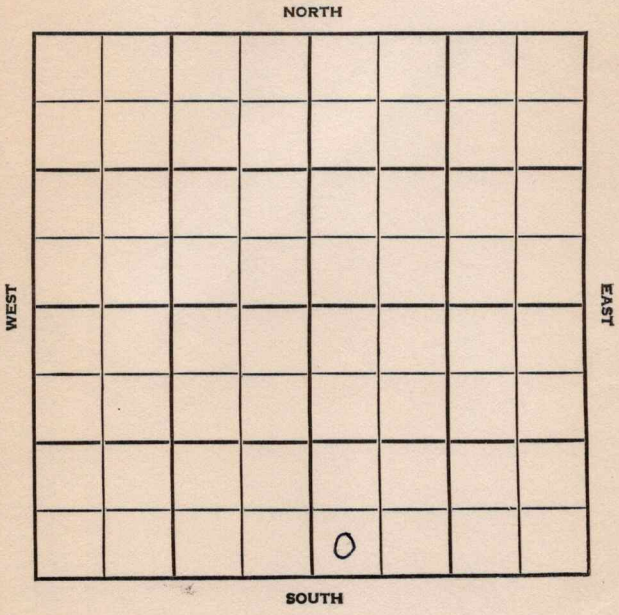

Barton KANSAS

SEC.	TWP.	R.
4	20	13W

WELL NO.
#1 Service Oil FARM

COMPANY
Petroleum Inc.

CONTRACTOR
Garvey
South Bend


_____ Ft. from N. Line

_____ Ft. from S. Line

_____ Ft. from E. Line

_____ Ft. from W. Line

SW SW SE

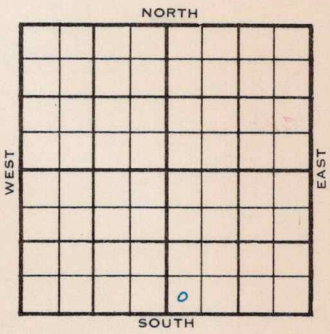

1955 ELEVATION 1856' REPORT

8/17 Location

10/19 Comm 8-17-55
8 5/8" @ 250/200
Anh 720
H 3065'
Dg 3100
Bl 3180
L 3193
TD 3497
DST 3196-3215 open 45 min. Rec 30' mud 0# DST 3215-55 open 1 hr Rec 30' vsocm 80# DST 3314-35 open 1 hr rec 1620' gas Rec 90' ho & gcm 680# DST 3338-46 open 1 hr Rec 300' oil 3' D'froggy oil 30' muddy oil 550# 4 1/2" @ 3496/140 CO to 3376 24/3338-44 2500 A S/5 boph PB 3330 20/3318-22 2500 A S/10 boph CO to 3375
Comp 28 bopd 2% wt5.

COMPLETED

DX-78

FORM 513 REV. SUNRAY

County Barton Elev.

Sec. 4 Twp. 20 Rge. 13W

Company Petroleum Inc.

Farm Name Service Oil No. 1

TOPS	DEPTH	LOG	DATUM
Anh.			
T.P.			
H.			
Tr.			
Dg.			
B.L.			
L.			
K.C.			
B.K.C.			
Ce.			
C.			
M.			
M.			
K.			
Mz.			
Mq.			
V.			
S.			
S.			
A			
R.			
P€.			
G.			
T.D.			

Loc. in Sec. SW SW SE

Geol.

Contr. Garvey

Pool South Bend

AUG 17 '51

FIRST REPORT

Date Comm.

Location

Co. Lse. No. Sec. T. R.

FORM 513 REV. SUNRAY

County Barton Elev. 1856

Sec. 4 Twp. 20 Rge. 13W

Company Petroleum Inc.

Farm Name Service Oil No. 1

TOPS	DEPTH	LOG	DATUM
Anh.	720		
Tp.			
H.	3060		1209
Tr.			
Dg.	3100		1244
B.L.	3180		1324
L.	3193		1337
K.C.			
B.K.C.			
Ce.			
C.			
M.			
M.			
K.			
Mz.			
Mo.			
V.			
S.			
S.			
A			
R.			
P€.			
G.			
T.D.	3497		

Loc. in Sec. SW SW SE

Geol.

Contr. Garvey

Pool South Bend

COMPLETE

Date Comm. 8-17-55 OCT 19 1955

8 5/8" @ 250/200 DST 3196-3215

open 45 min. Rec. 30' mud 0#

DST 3215-55 open 1 hr. Rec. 30' vsocm

80# DST 3314-35 open 1 hr. rec.

1620' gas Rec. 90' ho & gcm 680#

DST 3338-46 open 1 hr. Rec. 300' oil

30' froggy oil 30' muddy oil 550#

4½" @ 3496/140 CO to 3376 24/ 3338-44

OVER

Co. Lse. No. Sec. T. R.

2500 A S/ 5 boph PB 3330 20/ 3318-22
2500 A S/ 10 boph CO to 3375
Comp. 28 bopd 2% w tr.

Scout Cards
Land Small Map
Land Wall Map
Tracings
France Map
Pierce Map
Misc.

OCT 28 1955

74-3493