KANSAS


FORM 51

Barton

Section 4 Township 20 Range 13 W

Well No. # 1 Weathers

Company Leon Huff & Fleming & Woodman

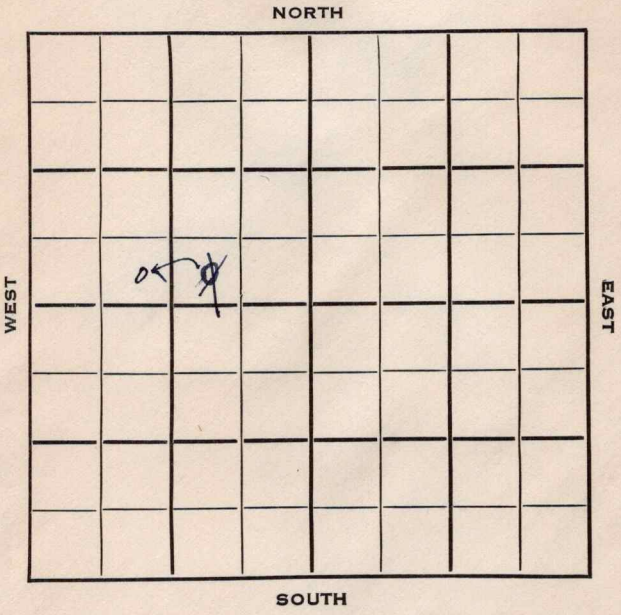

FORM 252-B
10M 10-50 PETROL

Barton KANSAS

Sec. 4 Twp. 20 R. 13W

Well No. #1 Weathers Farm

Leon Huff & Fleming & Woodman Company

Fleming & Woodman Contractor

Wildcat


Ft. from N. Line

330 Ft. from S. Line

~~990~~ Ft. from E. Line

990 Ft. from W. Line

~~SW SE NW~~
SE SW NW

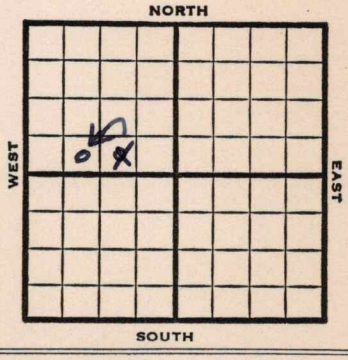

1953	Elev. 1853' REPORT
6/10	MIR
6/24	Spud 6-11-53 D & A TD 3486 8" @ 281 Anhy 720 Heeb 3082 Br lime 3193 Lans 3205 Cong 3443 Arb. 3483 TD 3486 D & A

ABANDONED

FORM 275 FOR SALE BY KANSAS BLUE PRINT CO.

County Barton State Kansas

Sec. 4 (Blk. Twp.) 20 (Sur. Rge.) 13W Map No.

Operator Leon Huff & Fleming & Woodman

Well No. 1 Farm Weathers

Elev. Location SW SE NW



330 Ft. From S Line NW

990 Ft. From E Line Quarter

1st. Report JUN 10 1953

Completion

Remarks Fleming & Woodman - Contr

Spudding Date

Drlg. Data Wildcat

M I R

J. G. McGEHEE

FORM 26 200 BKS. 4-52 PETROL

Kansas

Map No. _____ Sec. 4 Twp. 20 R. 13W

Well No. 1 Weathers


Leon Huff & Fleming & Woodman Company

CORRECTION

Contractor

SE SW NW

SECTION PLAT

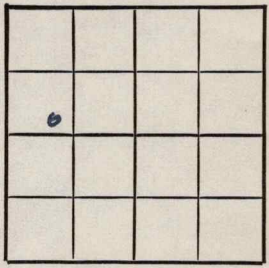

_____ Ft. from N. Line

330 Ft. from S. Line

_____ Ft. from E. Line

990 Ft. from W. Line

Barton County

Location _____

Rig up _____

Drilling and Remarks:

Reported
SW SE NW

RECORD

Cased _____ in., _____ ft.

Sand _____

Gas _____

Oil _____

Total Depth _____

PRODUCTION

1st 24 hrs. Nat. _____

1st 24 hrs. after shot _____

Gas _____ Cu. Ft.

Dry Hole _____

Abandoned _____

Date

JUN 17 1953 19

J. G. McGEHEE Scout

FORM 275 FOR SALE BY KANSAS BLUE PRINT CO.


County Barton State Kansas

Sec. 4 (Blk. Twp.) 20 (Sur. Rge.) 13W Map No.

Operator Leon Huff & Fleming & Woodman

Well No. 1 Farm Weathers

Elev. 1853 Location SE SW NW

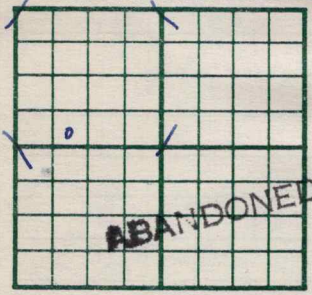

330 Ft. From S Line NW

990 Ft. From W Line Quarter

1st. Report

Completion JUN 2 4 1953

Remarks Wildcat

Fleming & Woodman - Contr

Spudding Date 6-11-53

Drlg. Data D & A TD 3486

8" @ 281 Anhy 720 Heeb. 3082

Br. lime 3193 Lans. 3205 Cong. 3443

Arb. 3483 TD 3486

D & A

J. G. McGEHEE