DX 78-1


Barton

KANSAS

Section 3 Township 20 Range 13W

Well No. #1 McMullen

Company Duke & Wood

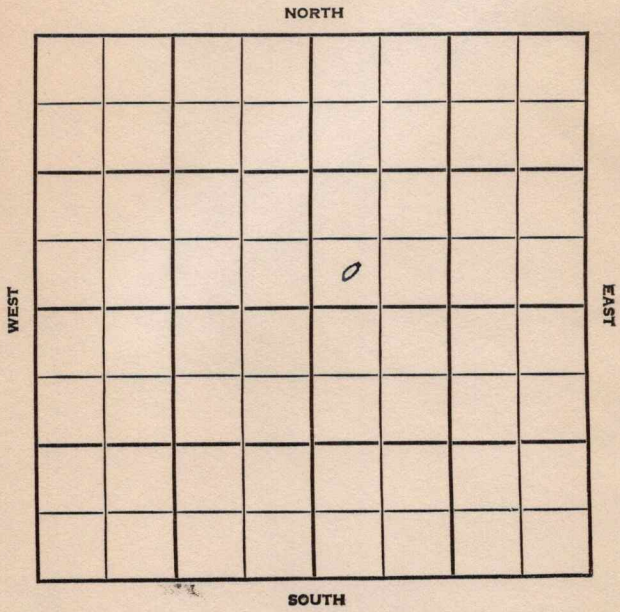

Barton KANSAS

SEC.	TWP.	R.
3	20	13W

WELL NO. #1 McMullen FARM

COMPANY Duke & Wood

CONTRACTOR Co. Tools

Wildcat.


_____ Ft. from N. Line

330 Ft. from S. Line

_____ Ft. from E. Line

330 Ft. from W. Line

SW SW NE

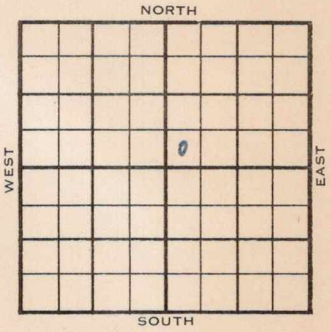

1955	ELEVATION 1845' REPORT
1/12	MIR
2/9	Spud 1-11-55 - D&A TD 3512' 8-5/8" @ 245' Anhy 700', Heeb.3071', Br lime 3186', Lans 3196' DST 3214-76', opn 1 hr., rec.30' mud, 500# Cong. 3434', Arb. 3437' DST 3438-48', opn 1 hr., rec. 660' free gas 15' gcm, 0# DST 3448-69', opn 1 hr., g as in 15", xxxxxxxxxx rec. 45' gcm, 795# DST 3469-76, opn 1 hr., gas in 8", rec. 29' gcm, 625# DST 3476-95', opn 1 hr., gas in ½ hr. Rec.130' muddy gassy oil, 60' free gassy oil, 975# TD 3510' 5" @ 3509' DD 3512', FU 20 gfph, 85% wtr. PB 3500', 24/3488-94, FU 1 bo 500A S/20 bo 80 bw 5 hrs. PB 3497' 7 bfph 95% wtr. PB 3488' 16/3474-78', 24/3482-88, 500A

DX-78

OVER

745508

(Information Brought Forward)

1955
2/9 S/15 goph 50% wtr., 1500A
S/3½ bfph 15% oil
D&A

ABANDONED

FORM 275 FOR SALE BY KANSAS BLUE PRINT CO.

County Barton State Kansas

Sec. 3 (Blk. Twp.) 20 (Sur. Rge.) 13W Map No.

Operator Duke & Wood

Well No. 1 Farm McMullen

Elev. Location SW SW NE



330 Ft. From S Line NE

330 Ft. From W Line Quarter

JAN 12 1955

1st. Report

Completion

Remarks

Spudding Date

Drlg. Data Wildcat

M I R

FABEN GILSTRAP

FORM 275 FOR SALE BY KANSAS BLUE PRINT CO.

County Barton State Kansas

Sec. 3 (Blk. Twp.) 20 (Sur. Rge.) 13W Map No.

Operator Duke & Wood

Well No. 1 Farm McMullen

Elev. 1845 Location SW SW NE



330 Ft. From S Line NE

330 Ft. From W Line Quarter

1st. Report

Completion FEB 9 1955

Remarks Wildcat

Co. tools

Spudding Date 1-11-55

Drlg. Data D & A TD 3512

8 5/8" @ 245 Anhy 700 Heeb. 3071

Br. lime 3186 Lans. 3196 DST 3214-76

open 1 hr. Rec. 30' mud 500#

Cong. 3434 Arb. 3437 DST 3438-48

open 1 hr. Rec. 660' free gas 15' gcm

0# DST 3448-69 open 1 hr. gas in 15 mi

Rec. 45' gcm 795# DST 3469-76

open 1 hr. gas in 8 min. Rec. 29' gcm

625# DST 3476-95 open 1 hr. gas in

½ hr. Rec. 130' muddy gassy oil 60' free

gassy oil 975# TD 3510 5" @ 3509

DD 3512 FU 20 gfph 85% wtr. PB 3500

24/ 3488-94 FU 1 bo 500 A S/ 20 bo

80 bw 5 hr. PB 3497 7 bfph 95% wtr.

OVER FABEN GILSTRAP

Drlg. Data

PB 3488 16/ 3474-78 24/ 3482-88

500 A S/ 15 goph 50% wtr. 1500 A

S/ 3½ bfph 15% oil

D & A

FEB 15 1955

80554L