DX 78-1


Barton

KANSAS

Section 4 Township 20 Range 13W

Well No. #1 Campbell

Company Schermerhorn - Thunderbird Drlg.

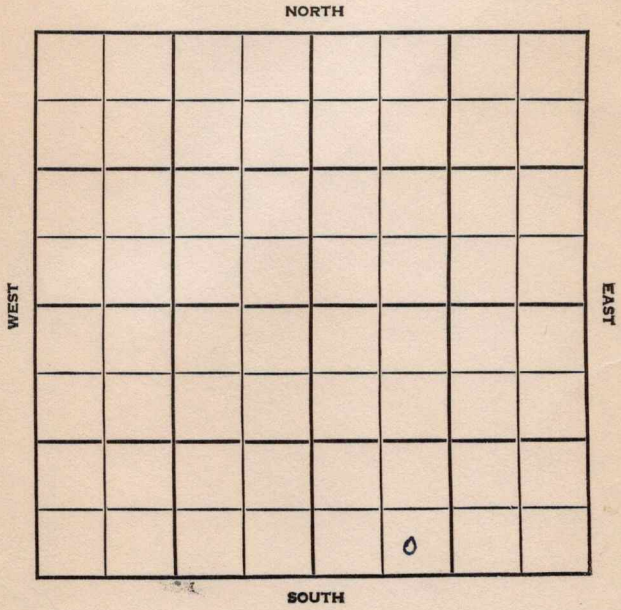

Barton

KANSAS

SEC.	TWP.	R.
4	20	13W

WELL NO.

#1 Campbell FARM

COMPANY

Schermerhorn - Thunderbird Drlg.

CONTRACTOR

Badger.


_____ Ft. from N. Line

330 Ft. from S. Line

_____ Ft. from E. Line

990 Ft. from W. Line

SE SW SE

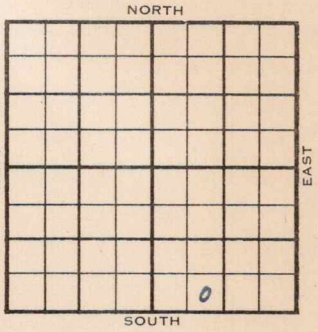

	ELEVATION	REPORT
1955	1855'	
1/12	MIR	
1/26	Spud 1-8-55 D & A TD 3545' 8-5/8" @ 727' Anhy 722' Lans 3203' DST 3305'-20' opn ½ hr, rec 10' Mud, 0# DST 3315'-35' opn 25 min, rec 10' Mud 0# DST 3385'-3422' opn 1 hr, rec 120' gas, 35' wm, 70# Halliburton Log Tops: Heeb 3073', Tor 3094', Br. Lime 3188' Lans 3201' Cong 3428' Arb. 3514' TD 3545' D & A	ABANDONED

DX-78

FORM 275 FOR SALE BY KANSAS BLUE PRINT CO.

County Barton State Kansas

Sec. 4 (Blk. Twp.) 20 (Sur. Rge.) 13W Map No.

Operator Schermerhorn - Thunderbird Drlg.

Well No. 1 Farm Campbell

Elev. Location SE SW SE



330 Ft. From S Line SE

990 Ft. From W Line Quarter

1st. Report JAN 12 1955

Completion

Remarks

Spudding Date

Drlg. Data

MIR

FABEN GILSTRAP

FORM 275 FOR SALE BY KANSAS BLUE PRINT CO.

County Barton State Kansas

Sec. 4 (Blk. Twp.) 20 (Sur. Rge.) 13W Map No.

Operator Schermerhorn

Well No. 1 Farm Campbell

Elev. 1855 Location SE SW SE



330 Ft. From S Line SE

990 Ft. From W Line Quarter

1st. Report

Completion JAN 2 6 1955

Remarks

Badger - Contr.

Spudding Date 1-8-55

Drlg. Data D & A TD 3545

8 5/8" @ 727 Anhy 722 Lans. 3203

DST 3305-20 open ½ hr. Rec. 10' mud

0# DST 3315-35 open 25 min. Rec. 10' mud

0# DST 3385-3422 open 1 hr. Rec. 120'

gas 35' wm 70# HALLIBURTON LOG TOPS:

Heeb. 3073 Tor. 3094 Br. lime 3188

Lans. 3201 Cong. 3428 Arb. 3514 TD 3545

D & A

FABEN GILSTRAP