


Rice KANSAS

SECTION 34 TOWNSHIP 18S RANGE 10W

WELL NO. #1 Wessler

COMPANY Isern Bros.

NORTH SW NW NW

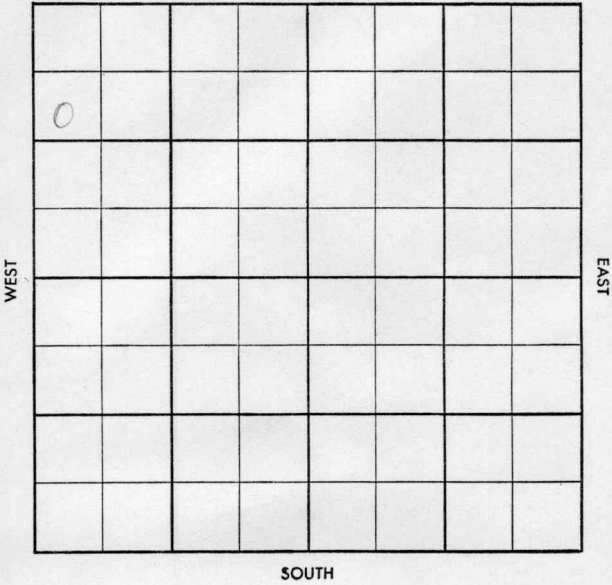



County Rice Elev. _____

Sec. 34 Twp. 18 Rge. 10W

Company Isern Bros.

Farm Name Wessler No. 1

TOPS	DEPTH	LOG	DATUM
Anh.			
Tp.			
H.			
Tr.			
Dg.			
B.L.			
L.			
K.C.			
B.K.C.			
Ce.			
C.			
M.			
M.			
K.			
Mz.			
Mq.			
V.			
S.			
S.			
A.			
R.			
Pf.			
G.			
T.D.			

Loc. in Sec. SW NW NW

Geol. _____

Contr. _____

Co. Tools # 1

Pool _____

Munyon



Date Comm. 34501 test.

Location.

Co.

Lse.

No.

Sec.

T.

R.

~~Twp. Pool~~ No

S-513-B

County Rice Elev. 1740 DF 1743 RB
 Sec. 34 Twp. 18 Rge. 10W
 Company Isern Bros.
 Farm Name Wessler No. 1

TOPS	DEPTH	LOG	DATUM	Loc. in Sec.
Anh.				SW NW NW
Tp.				
H.	2763			
Tr.	2786			
Dg.				
B.L.	2889			
L.	2908			W Geol. Johnson
K.C.				Contr.
B.K.C.				
Ce.				
C.	sd	3212		Co. Tools #1
M.				
M.				Pool
K.				Munyon
Mz.				
Mq.				
V.				
S.				
S.				
A.				
R.				
Pf.				
G.				ABANDONED
T.D.	3317			

Date Comm. 3450' test.
 Location. AUG 27 '58 8-21-58 8" 200' #2677

SEP 3 '58 DST 3211-25 1hr 10' WM
BAP 0' 20" - 565/20"

D & A

SI 1740

TD 1577