

KANSAS


Barton

FORM 51 5M PETROL

Section 6 Township 20 Range 13-W

Well No. #1 Nicholet

Company Vicker Pet.

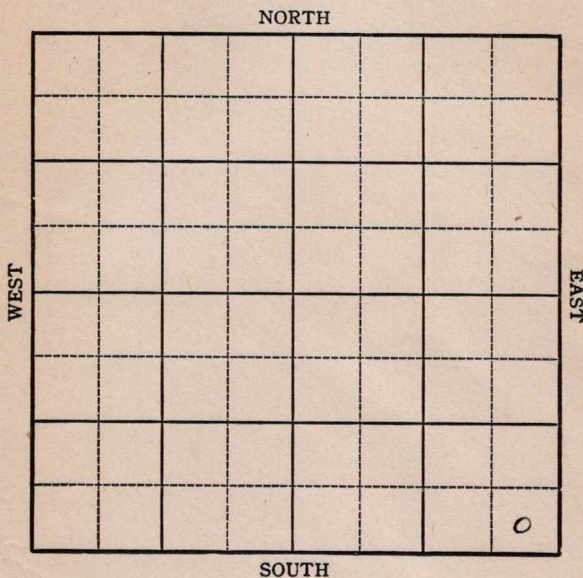

KANSAS


Barton

Sec. 6 Twp. 20 R. 13-W

Well No. #1 Nicholet Farm

Vickers Pet. Company

NORTH

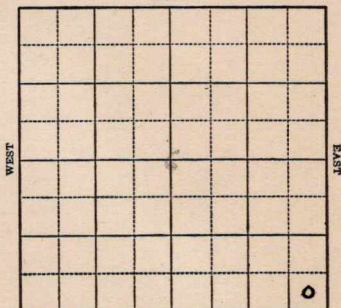

SOUTH

 Ft. from N. Line

330 Ft. from S. Line

330 Ft. from E. Line

 Ft. from W. Line

SE SE SE

1943 **Elev. 1868** R E P O R T

9/7 Building Derrick (Telephone)

9/8 Derrick 9/15 10" @ 3407

9/21 **Arbuckle 3471** **Anhy. 768'**

Total Depth 3474 **Lans. 3216**

Stains

Run 5" @ 3471'

9/22 SSO 3216-19, 3355-60

12' higher than our #1 Harrison (Telegram)

9/23 Drilling cement today (Tel)

9/29 T.D. 3538' water-small show oil.

10/6 **Arb 3471**

5" @ 3471

Water

T.D. 3553'

ABANDONED

Barton

Map No. 82 Sec. 6 Twp. 20 R. 13W

Well No. 1 Nicholet

Vicker s petroleum

Company

FIRST REPORT

Contractor

SE/C

SECTION PLAT

Ft. from N. Line

330

Ft. from S. Line

330

Ft. from E. Line

Ft. from W. Line

Wildcat

A 4x4 grid with a small 'e' in the second row, first column and a small 'o' in the fourth row, fourth column.

Location

Rig up.

Drilling and Remarks:

Derrick

RECORD

Cased _____ in., _____ ft.

Sand

Gas

Oil

Total Depth

PRODUCTION

1st 24 hrs. Nat.

1st 24 hrs. after shot

Gas_____ Cu. Ft.

Dry Hole.

Abandoned

Date _____

SEP 8

1943 19


S. J. LEWIS

Scout

KANSASMap No. 825 Sec. 6 Twp. 20 R. 13WWell No. 1 NicholetVickers Petroleum CompanyABANDONED Contractor

SE/C

SECTION PLAT

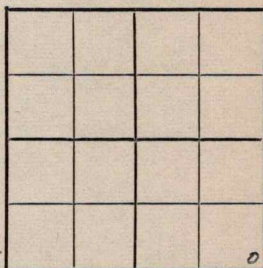 Ft. from N. Line330 Ft. from S. Line330 Ft. from E. Line Ft. from W. LineWildcatLocation Rig up

Drilling and Remarks:

Cor 8471511 @ 3471Water.

RECORD

Cased in., ft.Sand Gas Oil Total Depth 3553

PRODUCTION

1st 24 hrs. Nat. 1st 24 hrs. after shot Gas Cu. Ft.Dry Hole Abandoned

Date

OCT 6 1943 19S. J. LEWIS Scout