


Section 7 Township 20 Range 13 W

Well No. # 1 Taylor

Company Grant Oil

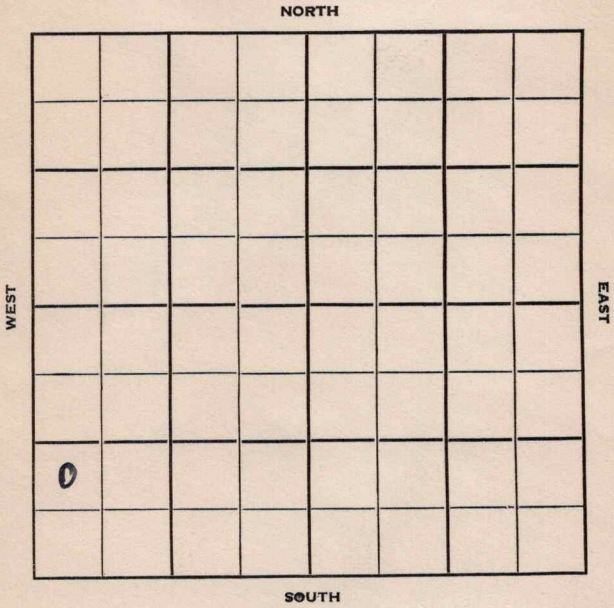

Sec. 7 Twp. 20 R. 13W

Well No. #1 Taylor Farm

Grant Oil Company

Contractor

Ft. from N. Line

990'


Ft. from S. Line

Ft. from E. Line

330'

Ft. from W. Line

NW SW SW

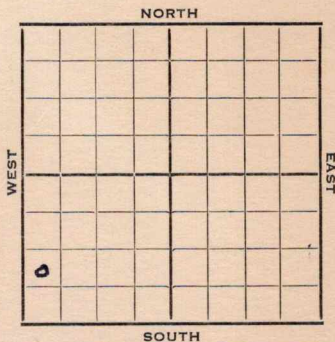

1952

Elev. 1874'

REPORT

6/11

Drlg.

6/19

Spud 5-31-52

D&A TD 3576

8" @ 800 Lans. 3240 Cong 3472

Viola 3499 Simp 3517 Arb. 3536

TD 3576 D&A

**ABANDONED**



