

KANSAS


Barton County

FORM 51 5M PETROL

Section 8 Township 20 Range 13W

Well No. 1 Pillar

Company W. L. Hartman

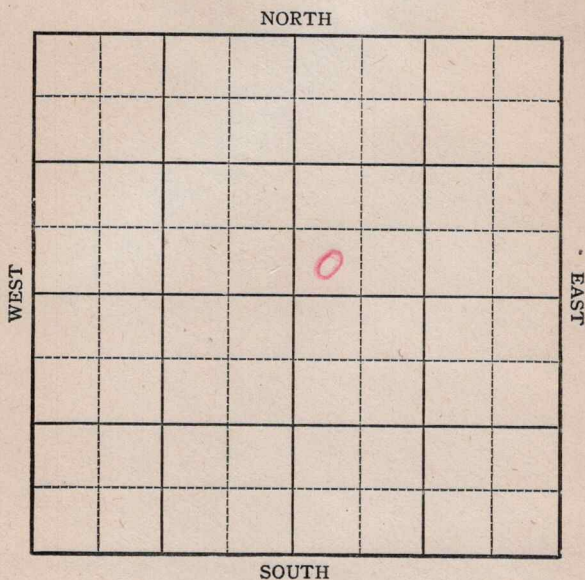

KANSAS

Barton

Sec. 8 Twp. 20 R. 13W

Well No. 1 Pillar Farm

W. L. Hartman Company


Wildcat

 Ft. from N. Line

330 Ft. from S. Line

 Ft. from E. Line

330 Ft. from W. Line

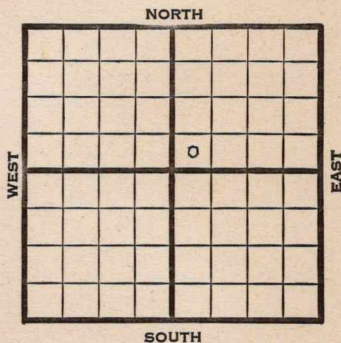

SW NE Elev. 1873

1945

REPORT

5/16

Location

5/24

8" @ 433

Anhy

710

Drlg. 1774

5/31

Lans 3216?

Drlg. 3234

6/8

Lans 3220 Cong 3458 Arb. 3504

TD 3518 SD 5" @ 3506 RUST

6/27

Arb. 3504

5" @ 3506

TD 3547' Water

ABANDONED

Kansas Pool Name WildcatMap No. 82 Sec. 8 Twp. 20 R. 13WWell No. 1 PillarW. L. Hartman


Company

FIRST REPORT

Contractor

SW NE

SECTION PLAT

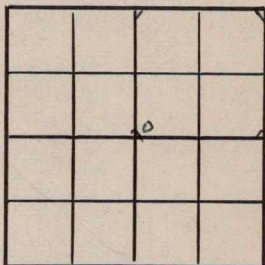

Ft. from N. Line

330

Ft. from S. Line

Ft. from E. Line

330

Ft. from W. Line

BartonLocation X

Rig up

Drilling and Remarks:

RECORD

Cased _____ in., _____ ft.

Sand _____

Gas _____

Oil _____

Total Depth _____

PRODUCTION

1st 24 hrs. Nat. _____

1st 24 hrs. after shot _____

Gas _____ Cu. Ft.

Dry Hole _____

Abandoned _____


Date

MAY 16 1945 19S. J. LEWIS

Scout

Kansas Pool Name WildcatMap No. 82 Sec. 8 Twp. 20 R. 13WWell No. 1 PillarW. L. Hartman CompanyABANDONED Contractor

SW NE

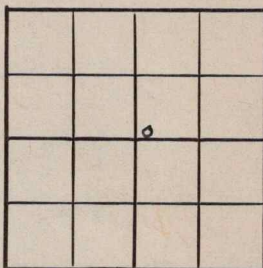E 1/8 23
SECTION PLAT Ft. from N. Line330 Ft. from S. Line Ft. from E. Line330 Ft. from W. LineBarton CountyLocation Rig up

Drilling and Remarks:

OK 35045" @ 3506Water

RECORD

Cased in., ft.Sand Gas Oil Total Depth 3547

PRODUCTION

1st 24 hrs. Nat. 1st 24 hrs. after shot Gas Cu. Ft.Dry Hole Abandoned

Date

JUN 27 194519S. J. LEWIS Scout