
FORM 51 10M 8-47

KANSAS Barton

Section 9 Township 18 Range 11W

Well No. #2 Ehly

Company R L Williams
Ames Pool

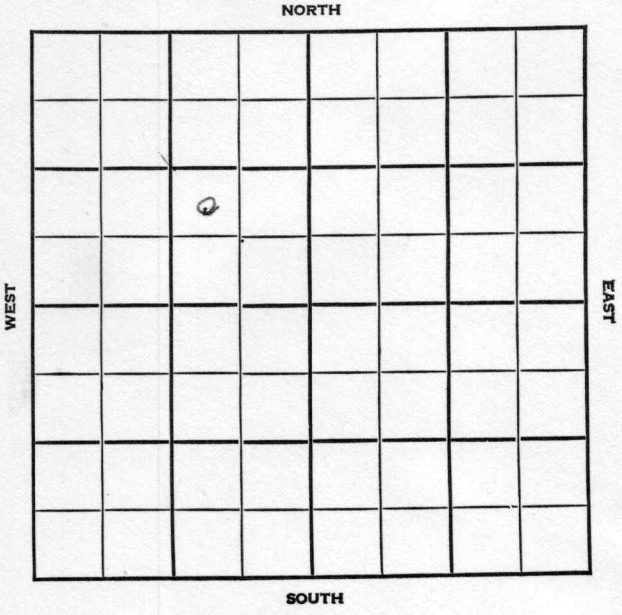

FORM 252-A
5M 12-45 PETROL KANSAS

Barton County

Sec. 9 Twp. 18 R. 11W

Well No. #2 Ehly Farm

R. L. Williams Company

Ames Pool


____ Ft. from N. Line

990 Ft. from S. Line

990 Ft. from E. Line

____ Ft. from W. Line

NW SE NW

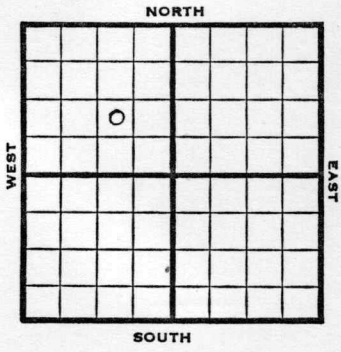

1948	Elev. 1778' REPORT
4/21	Surface Hole
4/28	8" @ 260' Drlg. 2770'
5/5	Lans. 3027' Arbuckle 3308' TD 3348' ABANDONED

Form 26—200 Bks.—1-48—Palace

Ames Pool

Kansas

Map No. _____ Sec. 9 Twp. 18 R. 11W


Well No. 2 Ehly

R. L. Williams Company

FIRST REPORT Contractor

NW SE NW

SECTION PLAT

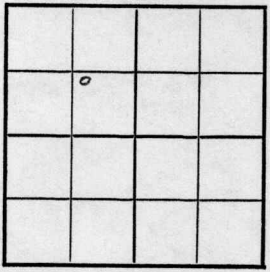

_____ Ft. from N. Line

990 Ft. from S. Line

990 Ft. from E. Line

_____ Ft. from W. Line

Barton County

Location _____

Rig up _____

Drilling and Remarks:

surface hole

RECORD

Cased _____ in., _____ ft.

Sand _____

Gas _____

Oil _____

Total Depth _____

PRODUCTION

1st 24 hrs. Nat. _____

1st 24 hrs. after shot _____

Gas _____ Cu. Ft.

Dry Hole _____

Abandoned _____

Date

APR 21 1948 19____ S. J. LEWIS Scout

Form 26—200 Bks.—1-48—Palace

Ames Pool

Kansas

Map No. 55 Sec. 9 Twp. 18 R. 11W

Well No. 2 Ehly


R. L. Williams Company

ABANDONED Contractor

NW SE NW

E.L. 1778

SECTION PLAT

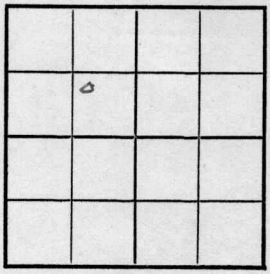

____ Ft. from N. Line

990 Ft. from S. Line

990 Ft. from E. Line

____ Ft. from W. Line

Barton County

Location

Rig up

Drilling and Remarks:

Lans 3027

RR 3808

RECORD

Cased ____ in., ____ ft.

Sand

Gas

Oil

Total Depth 3348

PRODUCTION

1st 24 hrs. Nat.

1st 24 hrs. after shot

Gas ____ Cu. Ft.

Dry Hole

Abandoned

Date

MAY 5 1948 19____ S. J. LEWIS Scout