

Barton


DX 78-1

KANSAS

Section 13 Township 18 Range 11W

Well No. #2 Zink

Company Petroleum Inc.

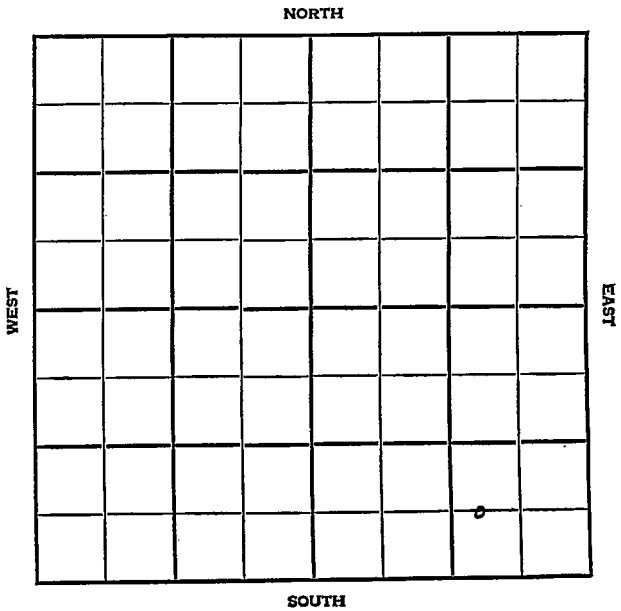





County Barton State KansasSec. 13 (Blk. 18) (Sur. 11W) (Twp.) (Rge.) Map No.Operator Petroleum Inc.Well No. 2 Farm ZinkElev. 1768 Location C W $\frac{1}{2}$  SE SE


660 Ft. From S Line SE990 Ft. From E Line Quarter

1st. Report

Completion OCT 20 1954Remarks Meadowside PoolCo. toolsSpudding Date 9-17-54Drlg. Data Oil well TD 32938" @ 229 Anhy 548 Heeb. 2860Lans. 2990 DST 2991-3006 open  $\frac{1}{2}$  hr.Rec. 15' drlg. mud 0# DST 3009-24open  $\frac{1}{2}$  hr. Rec. 15' drlg. mud 1000#DST 3071-79 open  $\frac{1}{2}$  hr. Rec. 10' mud815# Cong. 3275 Arb. 3286 DST 3286-93open 1 hr. Rec. 20' ho & gcm. 750#TD 3293 5" @ 3289 CO to 3293B/  $\frac{3}{4}$  boph 2500 A 2 bophComp. 163 bopd

FABEN GILSTRAP