

Barton

13

18

11 W

Section _____ Township _____ Range _____

Well No. # 2 Zink

Company Martin Wunderlich

NORTH

						0	

WEST

EAST

SOUTH

Barton

KANSAS

Sec. 13 Twp. 18 R. 11W

Well No. #2 Zink Farm

Martin Wunderlich Company

Contractor

Ft. from N. Line

990'


Ft. from S. Line

990'

Ft. from E. Line

Ft. from W. Line

NW SE NE

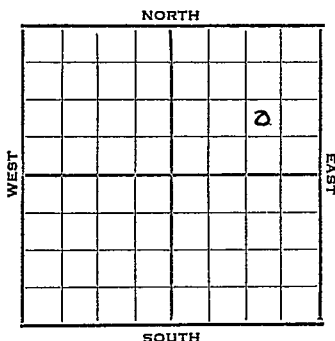

1951

Elev. 1777' REPORT

12/19

Spud 12-13-51
8" @ 200
Drlg. 775'

1952
2/6

TD 3284
4 1/2" @ 3283'
DD 3289', fill up 12 boph

2/13
2/20

No report
"


3/5

Spud 12-13-51
Oil well TD 3289' 8" @ 200
Heeb 2816' Br. lime 2974'
Lans. 2991' Arb. 3282'
TD 3289' 5" @ 3283' DD 3289'
FU 12 BOPH
Comp. 25 BOPD

COMPLETED

J. E. TYRA

County Barton State Kansas
 Sec. 13 (Blk. 18 (Sur. 11W Map No.
 (Twp.) (Rge.)
 Operator Martin Wunderlich
 Well No. 2 Farm Zink
 Elev. 1777 Location NW SE NE

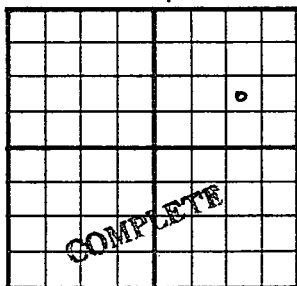

990Ft. From S Line NE
990Ft. From E Line Quarter
 1st. Report
 Completion MAR 5 1952
 Remarks

Spudding Date 12-13-51

Drlg. Data Oil well TD 3289
8" @ 200 Heeb. 2816 Br. lime 2974
Lans. 2991 Arb. 3282 TD 3289 5" @
3283 DD 3289 FU 12 boph Comp. 25 bopd