


Section 13 Township 18 Range 11W

Well No. #5 Zink

Company M. Wunderlich

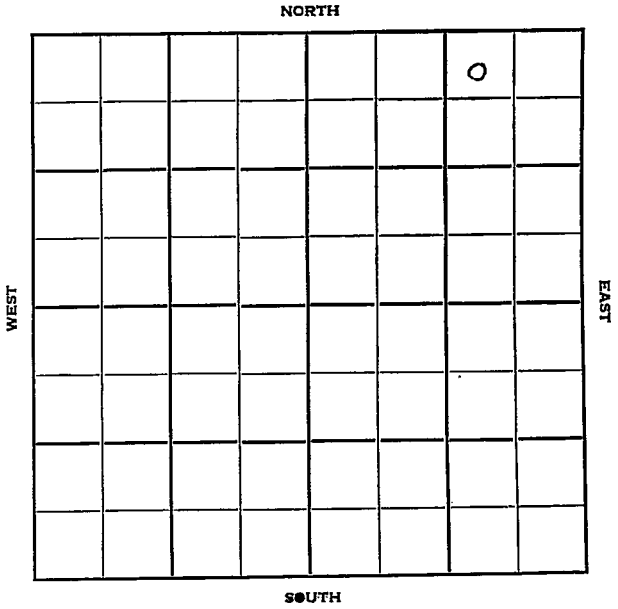

Barton

Sec. 13 Twp. 18 R. 11W

Well No. #5 Zink Farm

M. Wunderlich Company

Zink Contractor


330 Ft. from N. Line

_____ Ft. from S. Line

990 Ft. from E. Line

_____ Ft. from W. Line

NW NE NE

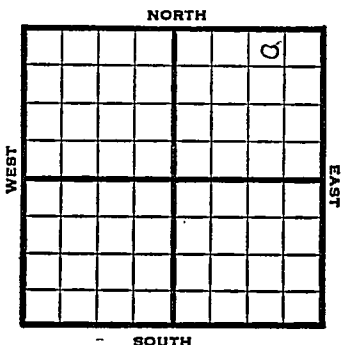

1952

Elev. 1779' REPORT

2/27

Heeb. 2861 Br Li 2975
 KC 2991 VSSO 3020-24
 Arb. 3285-88 TD
 4" @ 3286 DPDD 3291 T.D.
 Fill up 400' oil 2 hr.

3/5

Oil well TD 3291' Heeb 2861'
 Br. line 2975' KC 2991'
 VSSO 3020-24' Arb. 3285-88'
 4" @ 3286' TD 3291' FU 400'
 oil 2 hr.
 Comp. 25 BOPD

COMPLETED

