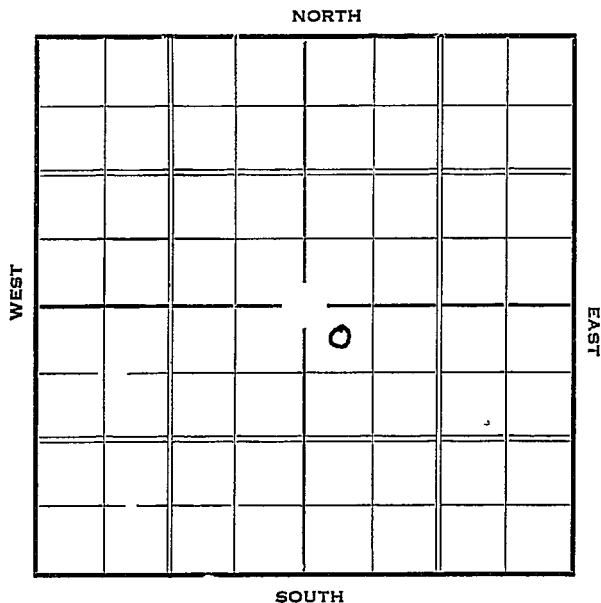
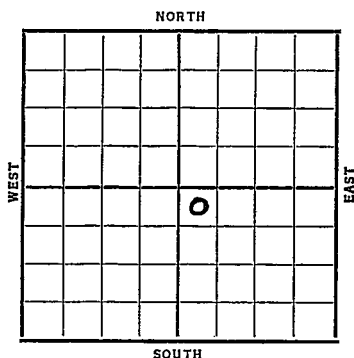


Section 13 Township 18 Range 11-WWell Number 1 - Joseph ZinkCompany Magnolia

Sec. 13 Twp. 18 R. 11-WWell No. #1 Joseph Zink Farm
Magnolia Company330 Ft. from N. Line Ft. from S. Line Ft. from E. Line330 Ft. from W. Line*elv. 1778*

Date

REPORT

1937

4/28

Location

5/7

13" @ 200'. WOG.

5/14

Drlg. 2515'.

5/21

S.O. 3021-26'. T.D. 3302'.

Reaming.

5/26

Sil. 3300'.

T.D. 3326'.

700' water.

ABANDONED

Barton KANSAS

Map No. 55 Sec. 13 Twp. 18 R. 11WWell No. 1 - Joseph ZinkMagnolia Company

Contractor

FIRST REPORT

SECTION PLAT

330 Ft. from N. Line

_____ Ft. from S. Line

_____ Ft. from E. Line

330 Ft. from W. Line

		0	

Location ✓

Rig up _____

Drilling and Remarks:

RECORD

Cased _____ in., _____ ft.

Sand _____

Gas _____

Oil _____

Total Depth _____

PRODUCTION

1st 24 hrs. Nat. _____

1st 24 hrs. after shot _____

Gas _____ Cu. Ft.

Dry Hole _____

Abandoned _____

Date

APR 28 1937

19

H. D. Hatfield Scout

Barton KANSASMap No. _____ Sec. *13* Twp. *18* R. *11 W*Well No. *1 - Joseph Zinc**magnolia* Company

Contractor

ABANDONED

SECTION PLAT

		0	

330 Ft. from N. Line

_____ Ft. from S. Line

_____ Ft. from E. Line

330 Ft. from W. Line

Location _____

Rig up _____

Drilling and Remarks:

*700' water**D+A*

RECORD

Cased _____ in., _____ ft.

Sand *511 3300*

Gas _____

Oil _____

Total Depth *3326*

PRODUCTION

1st 24 hrs. Nat. _____

1st 24 hrs. after shot _____

Gas _____ Cu. Ft.

Dry Hole _____

Abandoned _____

Date

MAY 26 1937

19

H. D. Hatfield

Scout