

Rice
20 R. 10^W

KANSAS

Map No. _____ Sec. 6 Twp. 20 R. 10^W

Well No. 2-Rice Farm _____


Mid-Continent Pet Corp. Company

990 Ft. from N. Line

_____ Ft. from S. Line

990 Ft. from E. Line

_____ Ft. from W. Line

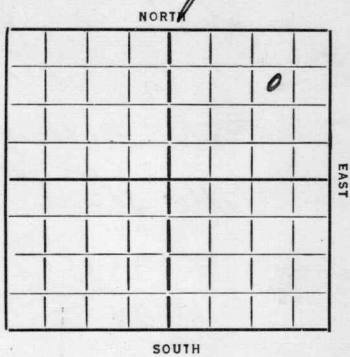

Elev. 1791

REPORT *Elev. 1791*

| | | |
|-----------------|------------------------------------|---------|
| 1935 | | |
| 12/18 | Material | |
| 12/26 | R & W Rotary | 12" 190 |
| 12/30 | T.D 215 | |
| | Setting surface pipe | (Tel) |
| 1/1/36 | Alg 1200 | (Tel) |
| 1/2 | " 1545 | (Tel) |
| 1/3 | " 1775 | (Tel) |
| 1/7 | " 2700 | (Tel) |
| 1/9 | " 2965 | (Tel) |
| 1/17 | 7" Top siliceous | 3288 |
| | T.D 3293 | |
| | Cored 3285-93 | |
| | 4' saturated lime | |
| 1/23 | T.D 3301 | |
| | 200' O.I.H | |
| | To drill deeper | (Tel) |
| 1/24 | Filled up 1000 feet Oil in 14 hrs. | |
| | Best Pay 3305-11 | |
| | T.D 3315 | |
| | Will swab | (Tel) |

OVER

1/25 Swabbed 107 Bbls Oil in
24 hrs
Will run tubing & acidize
with 2000 Gal (Tel)

Potential gauge:
1/29- 1st hr made 34 Bbls.
2nd " " 37 "
3rd " " 39 "
4th " " 21 "
5th " " 21 "
6th " down
7th " made 27 "
8th " " 27 "
9th " " 27 "
10th " " 32 "
11th " " 27 "
12th " " 32 "
13th " " 32 "
14th " " 27 "
15th " " 27 "
16th " " 21 "
17th " " 27 "
18th " " 27 "

1/30- Potential 24 hours 665 barrels

2/5 Sib 3288
TD 3315
2000 acid
Pot 665 Bbls.

OVER

COMPLETED

3/18 Shot 20 qts
CO to Bottom
Hole full Oil
Will start swabbing & pump
& acidize (Tel)
(NO O.W.D. TICKET YET)

3/21 After shot well was
swabbed to Stem
Swabbed 45 Bbls per hr
for 2 hrs then went back
in hole to clean casing out
Est 1000 Bbl well
2 feet casing in hole
CO (Tel)

3/26 Taking 24 hr pumping
test (Tel)

3/26 pumped 760 Bbls 24 hrs
(Tel)

6/8/36 - 6 Wrenches field test
#1 & #2 Riser 1256 Bbls
Old pot 1215 Bbls on 2
wells (Tel)

10/16/36--#1 & #2 Riser made 1,956 bbls.--New
#1 & #2 " " 1,256 " --Old
Increase---700 "

10/4/37--New potential 746 bbls. (Tel)

Map No. 4 Sec. 6 Twp. 20 R. 10W

Well No. 2-Risse

mid cont. pit Company

Contractor

FIRST REPORTS

SECTION PLAT

990 Ft. from N. Line

..... Ft. from S. Line

990 Ft. from E. Line

..... Ft. from W. Line

| | | | |
|--|--|--|---|
| | | | 0 |
| | | | |
| | | | ? |
| | | | |

Location.....

Rig up.....

Drilling and Remarks:

Material

RECORD

Cased.....in.,ft.

Sand.....

Gas.....

Oil.....

Total Depth.....

PRODUCTION

1st 24 hrs. Nat.....

1st 24 hrs. after shot.....

Gas.....Cu. Ft.

Dry Hole.....

Abandoned.....

Date

ORVAL MANNSCHECK

12-18-35 192.....

Scout

Map No. 46 Sec. 6 Twp. 20 R. 10W

Well No. 2-Risse

M.C.P.C. Company

Contractor

SECTION PLAT

990 Ft. from N. Line

..... Ft. from S. Line

990 Ft. from E. Line

..... Ft. from W. Line

| | | | |
|--|--|--|---|
| | | | 0 |
| | | | |
| | | | |
| | | | |
| | | | |

COMPLETED

Location.....

Rig up.....

Drilling and Remarks:

2000 acid

Prod 665 bbls

RECORD

Cased..... in., ft.

~~Sand~~ SIL 3288

Gas.....

Oil.....

Total Depth 3315

PRODUCTION

1st 24 hrs. Nat.....

1st 24 hrs. after shot.....

Gas..... Cu. Ft.

Dry Hole.....

Abandoned.....

Date

FEB 5 1936

192.....

ORVAL MANNSCHROSCOUT