

Section 33 Township 18 Range 10 WWell No. # 5 Buehler (A)Company Skelly

NORTH

WEST

EAST

0							

SOUTH

Sec. 33 Twp. 18 R. 10W

Well No. #5 Buehler (A) Farm

Skelly Company

Contractor


990 Ft. from N. Line

Ft. from S. Line

Ft. from E. Line

330 Ft. from W. Line

SW NW NW

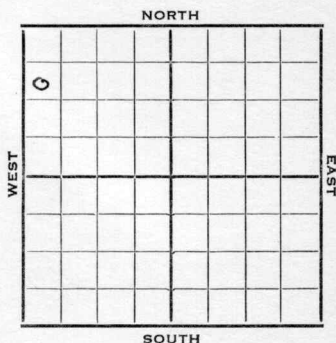

1952

Elev. 1739'

REPORT

4/30

Spud 4-27-52
430' anhy
8" @ 440' WOC

5/7

Drlg. 2580'

5/14

Topeka 2530
Tor 2752
Br Li 2851
Cong. 3130
5" @ 3152

Heeb. 2733
Douglas 2765
Lans. 2873
RTD 3152
WOC

5/21

DD 3188' 2 gal OPH

5/28

TD 3189' D-Hyd.

6/11

Spud 4-27-52
Oil Well TD 3189
Anhy 430 8" @ 440
Top 2530 Heeb. 2733
Tor. 2752 Doug 2765
Br Lime 2851 Lans. 2873
Cong. 3130 TD 3152
5" @ 3152 DD 3188
2 goph DD 3189 D-Hydra
P/40 bo 19 hr. Comp. 57 bopd

COMPLETED

County Rice State KansasSec. 33 (Blk.) 18 (Sur.) 10W Map No.Operator SkellyWell No. 5 Farm Buehler (A)Elev. Location SW NW NW

990 Ft. From N Line NW330 Ft. From W Line Quarter1st. Report APR 30 1952

Completion

Remarks

Spudding Date 4-27-52

Drlg. Data

Anhy 430 8" @ 440 WOC

J. G. McGEHEE

County Rice State Kansas
 Sec. 33 (Blk.) 18 (Sur.) 10W Map No.
 Operator Skelly Oil
 Well No. 5 Farm Buehler "A"
 Elev. 1739 Location SW NW NW



990 Ft. From N Line NW
330 Ft. From W Line Quarter
 1st. Report
 Completion JUN 11 1952
 Remarks

Spudding Date 4-27-52
 Drlg. Data Oil well TD 3189
Anhy 430 8" @ 440 Top. 2530
Heeb. 2733 Tor. 2752 Doug. 2765
Br. lime 2851 Lans. 2873 Cong. 3130
TD 3152 5" @ 3152 DD 3188
2 goph DD 3189 D-Hydro. P/ 40 bo
19 hr. Comp. 57 bopd

J. G. McGEHEE