

KANSAS

Barton

FORM 51 IOM 12-46 PETROL


Section 9 Township 18 Range 11-WWell No. 1 EhlyCompany R. L. Williams

Wildcat

NORTH

WEST

EAST

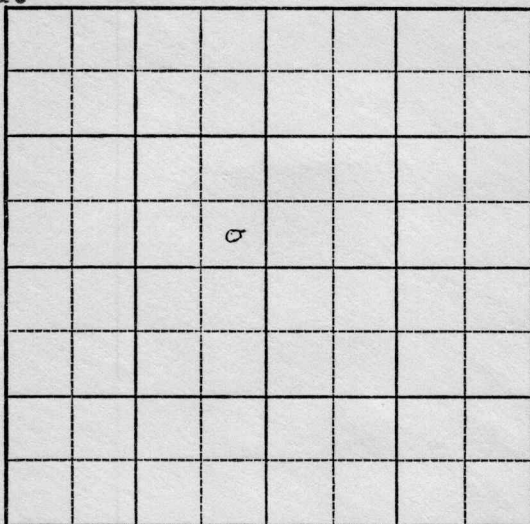

SOUTH

Barton

KANSAS

Sec. 9 Twp. 18 R. 11W

Well No. #1 Ehly Farm

R. L. Williams Company


Wildcat

 Ft. from N. Line

330 Ft. from S. Line

330 Ft. from E. Line

 Ft. from W. Line

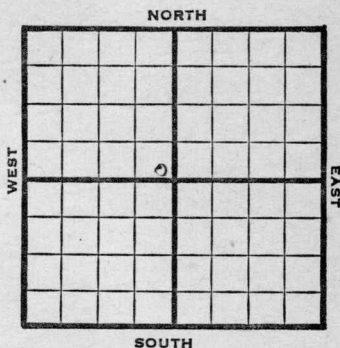

SE NW

SOUTH

1947 Elev. 1774' REPORT

10/8	Location
10/15	8" @ 225' Drlg. 580'
10/22	Drlg. 2898'
10/29	Arbuckle 3307' TD 3319' 5" @ 3309' RUST
11/5	"
11/12	SLM 3280- 85' Arbuckle 3312 5" @ 3314' TD 3318' Swb. 48 bbls. oil /16W in 4 hrs.
11/19	"
11/25	"
12/3	"
12/10	Arbuckle 3312' 5" @ 3314' Pump 1 B oil & 40% W. Gr. 41° Total Depth 3318'

COMPLETED

Map No. _____ Sec. 9 Twp. 18 R. 11W

Well No. 1 Ehly

R. L. Williams Company

FIRST REPORT Contractor

SE NW

SECTION PLAT

_____ Ft. from N. Line

330 Ft. from S. Line

330 Ft. from E. Line

_____ Ft. from W. Line

Barton County

Location X

Rig up _____

Drilling and Remarks:

RECORD

Cased _____ in., _____ ft.

Sand _____

Gas _____

Oil _____

Total Depth _____

PRODUCTION

1st 24 hrs. Nat. _____

1st 24 hrs. after shot _____

Gas _____ Cu. Ft.

Dry Hole _____

Abandoned _____

Date

OCT 8 1947 19 S. J. LEWIS Scout

Map No. 55 Sec. 9 Twp. 18 R. 11W

Well No. 1 Ehly

R. L. Williams Company

COMPLETE

Contractor

SE NW

E1,1774
SECTION PLAT

 Ft. from N. Line

330 Ft. from S. Line

330 Ft. from E. Line

 Ft. from W. Line

Barton County

Location

Rig up

Drilling and Remarks:

Ar 8312

5" 8314

Pump 1 Boil +

40% W.

41 2 4

RECORD

Cased in., ft.

Sand

Gas

Oil

Total Depth 8315

PRODUCTION

1st 24 hrs. Nat.

1st 24 hrs. after shot

Gas Cu. Ft.

Dry Hole

Abandoned

Date

DEC 10 1947 19

S. J. LEWIS

Scout