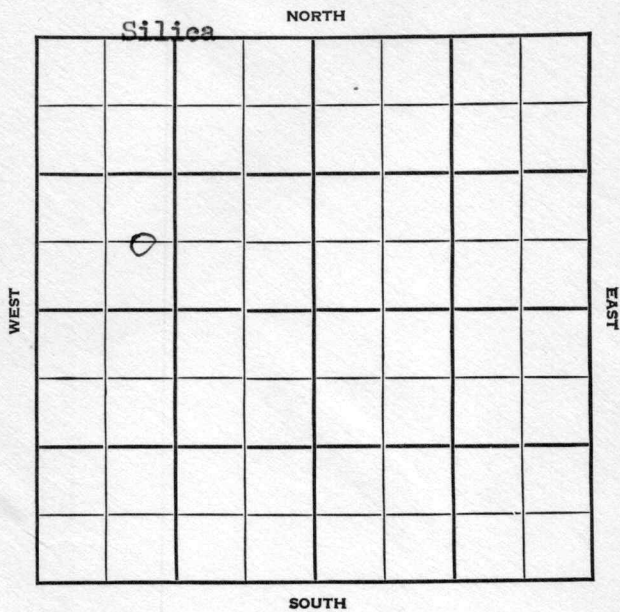


KANSAS

Rice

Section 6 Township 20 Range 10WWell No. 2 "A" BerscheidtCompany J. H. Tatloek

KANSAS

Rice

Sec. 6 Twp. 20 R. 10-W

Well No. #2 "A" Berscheidt Farm

J. H. Tatlock Company

Silica Pool


 Ft. from N. Line

660' Ft. from S. Line

 Ft. from E. Line

990' Ft. from W. Line

C E L SW NW

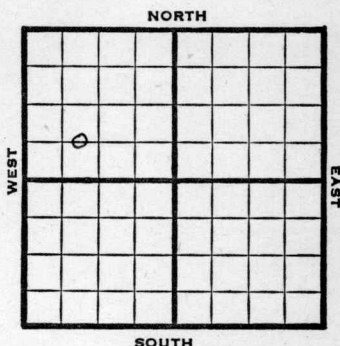

1947 Elev. 1772' REPORT

11/12 Lans. 3009'
TD 3021'
7" @ 3021'
WOC

11/19 TD 3074'
HFO

11/25 "

12/3 Lans. 3009'
7" @ 3021'
Flow 60 Pot
Gr. 42°
Total Depth 3074'

COMPLETED

Map No. _____ Sec. 6 Twp. 20 R. 10W

Well No. 2 "A" Berscheidt

J. H. Tatlock Company

FIRST REPORT

Contractor

C E L S W N W

SECTION PLAT

_____ Ft. from N. Line

660 Ft. from S. Line

_____ Ft. from E. Line

990 Ft. from W. Line

Rice County

Location _____

Rig up _____

Drilling and Remarks:

Lans. 3009

TD 3021

7" @ 3021 WOC

RECORD

Cased _____ in., _____ ft.

Sand _____

Gas _____

Oil _____

Total Depth _____

PRODUCTION

1st 24 hrs. Nat. _____

1st 24 hrs. after shot _____

Gas _____ Cu. Ft.

Dry Hole _____

Abandoned _____

Date

NOV 12 1947

19

S. J. LEWIS

Scout

Kansas

Map No. 46 Sec. 6 Twp. 20 R. 10WWell No. 2 "A " Berscheidt

J. H. Tatlock

Company


COMPLETE

Contractor

C E L SW NW

B41972

SECTION PLAT

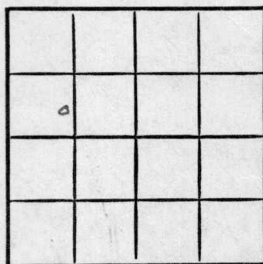

Ft. from N. Line

660 Ft. from S. Line

Ft. from E. Line

990 Ft. from W. Line

Rice County

Location

Rig up

Drilling and Remarks:

Lease 30097" O.S. 24Flow 60 Bbl42 c/s

RECORD

Cased _____ in., _____ ft.

Sand _____

Gas _____

Oil _____

Total Depth 3074

PRODUCTION

1st 24 hrs. Nat. _____

1st 24 hrs. after shot _____

Gas _____ Cu. Ft.

Dry Hole _____

Abandoned _____

Date

DEC 3 1947

19

S. J. LEWIS

Scout