


Rice

KANSAS

Section 6 Township 20 Range 10-W

Well Number ~~#~~ #2 J. Berscheidt "A"

Company Tatlock

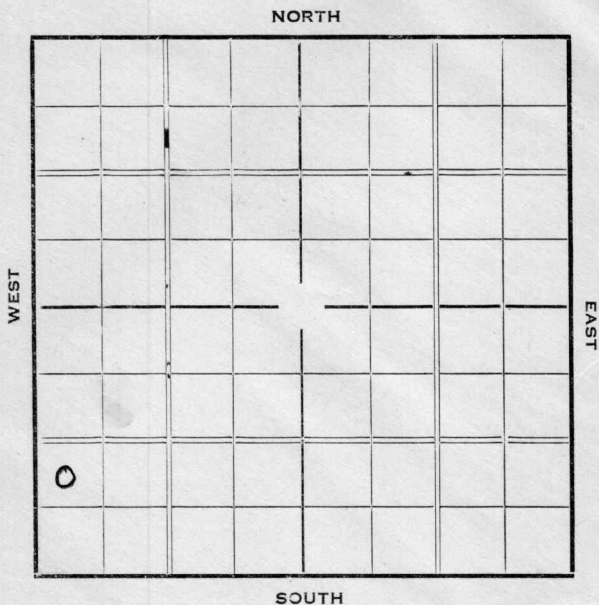

Map No. 46 Sec. 6 Twp. 20 R. 10W

Well No. H. Berscheidt

Mattock Company

Contractor

SECTION PLAT

0			

_____ Ft. from N. Line

990 Ft. from S. Line

_____ Ft. from E. Line

330 Ft. from W. Line

FIRST REPORT

Location _____

Rig up _____

Drilling and Remarks:

Rig

RECORD

Cased _____ in., _____ ft.

Sand _____

Gas _____

Oil _____

Total Depth _____

PRODUCTION

1st 24 hrs. Nat. _____

1st 24 hrs. after shot _____

Gas _____ Cu. Ft.

Dry Hole _____

Abandoned _____

Date

NOV 25 1936 19

S. J. LEWIS

Scout

Rice **KANSAS**

Map No. 46 Sec. 6 Twp. 20 R. 10W

Well No. 2. J. Berscheid "A"

Haddock

Company

Contractor

SECTION PLAT

o			

_____ Ft. from N. Line

990 Ft. from S. Line

_____ Ft. from E. Line

330 Ft. from W. Line

COMPLETED

Location _____

Rig up _____

Drilling and Remarks:

Sil 8266.

P 81733

RECORD

Cased _____ in., _____ ft.

Sand _____

Gas _____

Oil _____

Total Depth 3274

PRODUCTION

1st 24 hrs. Nat. _____

1st 24 hrs. after shot _____

Gas _____ Cu. Ft.

Dry Hole _____

Abandoned _____

Date

DEC 22 1936 19

S. J. LEWIS Scout