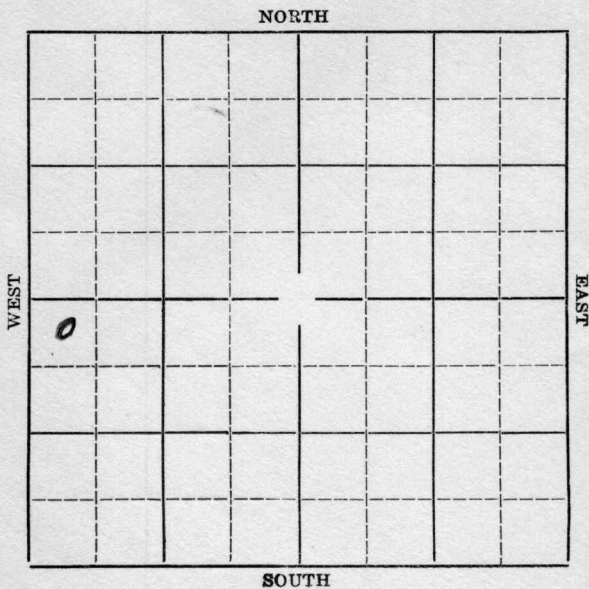


Section 6 Township 20 Range 10-WWell Number #2 ~~#8~~ J. Berschiedt "B"Company Tatlock

KANSAS

Rice

Sec. 6 Twp. 20 R. 10-W

Well No. ^{#2} ~~3~~ J. Berschiedt "B" Farm

Tatlock

Company


330 Ft. from N. Line

Ft. from S. Line

Ft. from E. Line

330 Ft. from W. Line

Elev. 1780

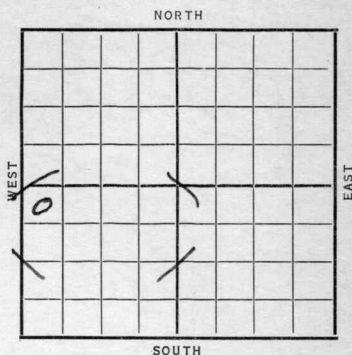

1936

REPORT

11/4	Location
------	----------

11/12	Rig
-------	-----

11/19----

11/27	10" @ 123'. Drlg. 1720'.
-------	--------------------------

12/3	Dr1g. 2870'.
------	--------------

12/10	Sil 3288' Drlg.
-------	-----------------

12/17	RUST.
-------	-------

12/22 Sil. 3282'. T. D. 3284'.

Pot. 2019.

COMPLETED

KANSAS

Map No. 46 Sec. 6 Twp. 20 R. 10WWell No. 3 J. BerschiedtHatlock

Company

Contractor

SECTION PLAT

0			

330 Ft. from N. Line

_____ Ft. from S. Line

_____ Ft. from E. Line

330 Ft. from W. Line

FIRST REPORT

Location ✓

Rig up _____

Drilling and Remarks:

RECORD

Cased _____ in., _____ ft.

Sand _____

Gas _____

Oil _____

Total Depth _____

PRODUCTION

1st 24 hrs. Nat. _____

1st 24 hrs. after shot _____

Gas _____ Cu. Ft.

Dry Hole _____

Abandoned _____

Date

NOV 4 1936 19

S. J. LEWIS Scout


KANSAS

Map No. 46 Sec. 6 Twp. 20 R. 10WWell No. 2 J. Berschied & "B"Thatcher

Company

Contractor

SECTION PLAT

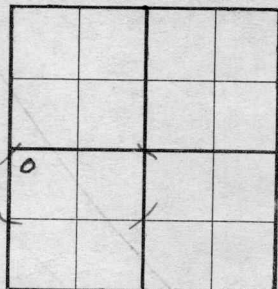330 Ft. from N. Line

_____ Ft. from S. Line

_____ Ft. from E. Line

330 Ft. from W. Line

CORRECTION

Location _____

Rig up _____

Drilling and Remarks:

Reported as
No. 8

RECORD

Cased _____ in., _____ ft.

Sand _____

Gas _____

Oil _____

Total Depth _____

PRODUCTION

1st 24 hrs. Nat. _____

1st 24 hrs. after shot _____

Gas _____ Cu. Ft.

Dry Hole _____

Abandoned _____

Date

DEC 16 1936

19

S. J. LEWIS Scout

KANSAS

Map No. 46 Sec. 6 Twp. 20 R. 10W.Well No. 2. J. Berschied & B.Patlock

Company

Contractor

SECTION PLAT

0			

330 Ft. from N. Line

Ft. from S. Line

Ft. from E. Line

330 Ft. from W. Line

COMPLETED

Location _____

Rig up _____

Drilling and Remarks:

Oil 3282.Per 2019

RECORD

Cased _____ in., _____ ft.

Sand _____

Gas _____

Oil _____

Total Depth 3284

PRODUCTION

1st 24 hrs. Nat. _____

1st 24 hrs. after shot _____

Gas _____ Cu. Ft.

Dry Hole _____

Abandoned _____

Date

DEC 22 1936

19

S. J. LEWIS

Scout