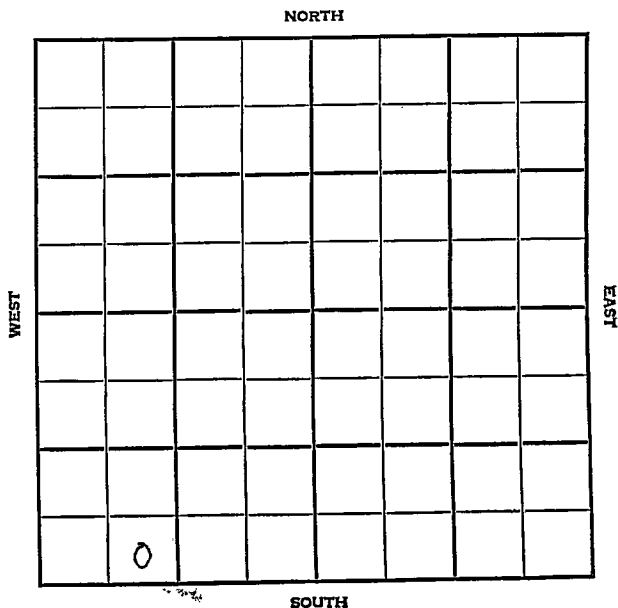


Section 11 Township 18 Range 11 WWell No. #1 RoeslerCompany Thunderbird Drlg.

Barton

KANSAS

SEC.	TWP.	R.
14	18	11W

WELL NO.

#1 Roesler

FARM

COMPANY

Thunderbird Drlg

CONTRACTOR

Co. Tools


Roesler

Ft. from N. Line

Ft. from S. Line

Ft. from E. Line

Ft. from W. Line

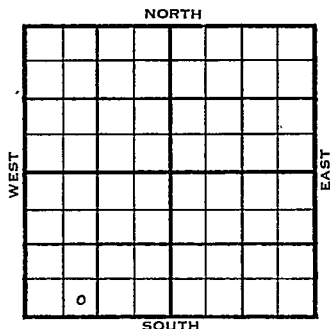

SE SW SW

1955	ELEVATION	REPORT
	1765'	

7/28

Comm 7-25-55

8" @ 217

WOC

8/10

H 2871

BL 2987

L 2999

A 3293

TD 3335

8" @ 217 DST 3175-92 open 1 hr

Rec 10' mud 80/20" DST 3295-3302

open 45 min. Rec 12' mud 0#

DST 3302-15 open 1 hr Rec 20' mud

1050/20" DST 3315-25 open 1 hr.

Rec. 470' vsocsw 1000/20"

D & A

ABANDONED

County Barton Elev. _____
 Sec. 14 Twp. 18 Rge. 11W
 Company Thunderbird Drlg.
 Farm Name Roesler No. 1

TOPS	DEPTH	LOG	DATUM	Loc. in Sec.
Anh.				SE SWSW
Tp.				
H.				
Tr.				
Dg.				
Bl.				
L.				Geol.
K.C.				Contr.
B.K.C.				Cor. tools
Ce.				Pool
C.				Roesler
M.				
M.				
K.				
Mz.				
Mo.				
V.				
S.				
S.				
A.				
R.				
Pe.				
G.				
TD.				

FIRST REPORT
 JUL 28 '55

Date Comm. 7-25-55
8th @ 217 WOC

15

County Barton Elev. 1765
 Sec. 14 Twp. 18 Rge. 11W
 Company Thunderbird Drlg.
 Farm Name Roesler No. 1

TOPS	DEPTH	LOG	DATUM	Loc. in Sec.
Anh.				SE SW SW
Tr.				
H.	2871		1106	
Tr.				
Dg.				
BL.	2987		1222	
L.	2999		1234	Geol.
K.C.				Contr.
B.K.C.				Co. tools
Ce.				Pool
C.				Roesler
M.				
M.				
K.				
Mz.				
Me.				
V.				
S.				
S.				
A	3293		1528	
R.				
PE.				
G.				
T.D.	3335			

Date Comm. AUG 10 1955

8" @ 217 DST 3175-92 open 1 hr.

Rec. 10' mud 80/20" DST 3295-3302

open 45 min. Rec. 12' mud 0#

DST 3302-15 open 1 hr. Rec. 20' mud

1050/20" DST 3315-25 open 1 hr.

Rec. 470' vsocsw 1000/20"

D & A

ABANDONED