




Map No. \_\_\_\_\_ Sec. 6 Twp. 20 R. 10<sup>W</sup> *Rice*

Well No. 3- Burscheidt Farm \_\_\_\_\_  
Tallock et al Company \_\_\_\_\_

330 Ft. from N. Line  
\_\_\_\_\_ Ft. from S. Line  
330 Ft. from E. Line  
\_\_\_\_\_ Ft. from W. Line

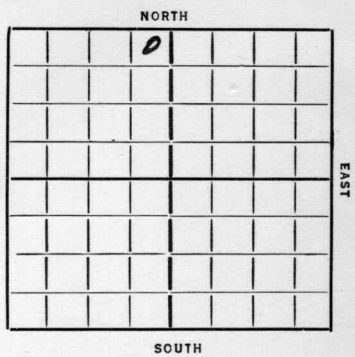

Elev. 1780

REPORT

Date	Location	
1935		
9/20	Location	
10/3	Rotary Rig	
10/10		
11/1	1820	12" 116
11/7	" 3110	
11/14	6" 3280	
11/21	Sil 3277 Oil 3283	
	TD 3291 3000' OSH 1 hr	
11/27	Sil 3277	
	TD 3291	
	1241 Bole.	

COMPLETED

Map No. 46 Sec. 6 Twp. 20 R. 10<sup>W</sup>

Well No. 3-Berscheidt

Tatlock et al Company

Contractor

FIRST REPORTS

SECTION PLAT

		0	

330 Ft. from N. Line

..... Ft. from S. Line

330 Ft. from E. Line

..... Ft. from W. Line

Location

Rig up .....

Drilling and Remarks: .....

RECORD

Cased.....in., .....ft.

Sand.....

Gas.....

Oil.....

Total Depth.....

PRODUCTION

1st 24 hrs. Nat.....

1st 24 hrs. after shot.....

Gas.....Cu. Ft.

Dry Hole.....

Abandoned.....

Date

9-20-35 192

ORVAL MANNSCHECK

Scout

KANSAS

Map No. 46 Sec. 6 Twp. 20 R. 10W

Well No. 3-Berscheid

Tatlock

Company

Contractor

COMPLETE

SECTION PLAT

330 Ft. from N. Line

..... Ft. from S. Line

330 Ft. from E. Line

..... Ft. from W. Line

	0		

Location.....

Rig up.....

Drilling and Remarks:

1241 bbls

RECORD

Cased..... in., ..... ft.

Sand Sil 3277

Gas.....

Oil.....

Total Depth 3291

PRODUCTION

1st 24 hrs. Nat.....

1st 24 hrs. after shot.....

Gas..... Cu. Ft.

Dry Hole.....

Abandoned.....

Date

11-27-35 192.....

ORVAL MANNSCHRECK

Scout