


Map No. K Sec. 35 Twp. 31 R. 4^E

Well No. #1 Mc Knab Farm

D. J. J. Oil Company

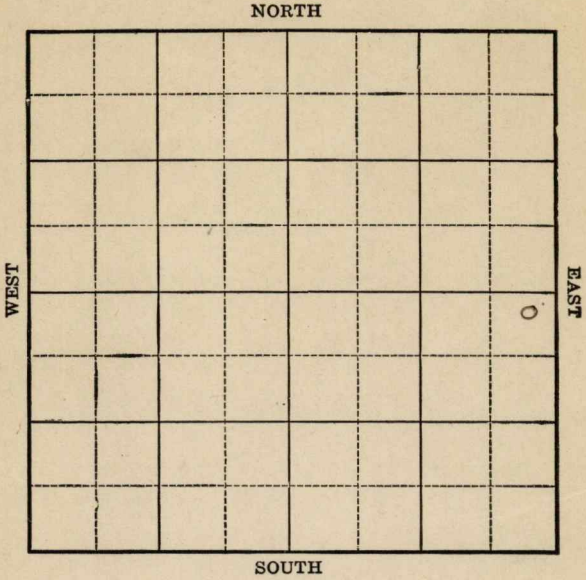

Location _____

Rig Up _____

Drilling Remarks:

Drilling Remarks:

RECORD

PRODUCTION

Cased _____ in. _____ ft.

1st 24 hrs. Nat. _____

Sand _____

1st 24 hrs. after shot _____

Gas _____

Gas _____ cu. ft.

Oil _____

Dry Hole _____

Total Depth _____

Abandoned _____

Map No. **KANSAS** Sec. *35* Twp. *31* R. *4*^E

Well No. *1 m^o Spab*

J. J. J. O. Company

Contractor

FIRST REPORT

SECTION PLAT

200 Ft. from N. Line

_____ Ft. from S. Line

200 Ft. from E. Line

_____ Ft. from W. Line

			0

Location _____

Rig up _____

Drilling and Remarks:

Timbers

RECORD

Cased _____ in., _____ ft.

Sand _____

Gas _____

Oil _____

Total Depth _____

PRODUCTION

1st 24 hrs. Nat. _____

1st 24 hrs. after shot _____

Gas _____ Cu. Ft.

Dry Hole _____

Abandoned _____

Date

NOV 12 1924

M. A. BENEAR

192_____

Scout

Map No. *10th* Sec. *35* Twp. *31* R. *4^E*

Well No. *1 Mc Keith*

J. J. J. Oil Company Company

Contractor

COMPLETED

SECTION PLAT

200 Ft. from N. Line

----- Ft. from S. Line

200 Ft. from E. Line

----- Ft. from W. Line

ABANDONED

			o

Location -----

Rig up -----

Drilling and Remarks:

Top line 2925

dry & khd

RECORD

Cased ----- in., ----- ft.

Sand -----

Gas -----

Oil -----

Total Depth *3501*

PRODUCTION

1st 24 hrs. Nat. -----

1st 24 hrs. after shot -----

Gas ----- Cu. Ft.

Dry Hole

Abandoned

Date

APR 10 1925

192

Chas. L. Sheward Scout

Cawley

MAP NO. **K2** **KANSAS** SEC. **35** TWP. **31S** R. **4E**

WELL NO. **1. Mc Knight**
Doster Sch

COMPANY

CONTRACTOR

SECTION PLAT

ABANDONED

			0

_____ FT. FROM N. LINE
 _____ FT. FROM S. LINE
 _____ FT. FROM E. LINE
 _____ FT. FROM W. LINE

LOCATION _____

RIG UP _____

DRILLING AND REMARKS:



RECORD

CASED _____ IN., _____ FT.

SAND _____

GAS _____

OIL _____

TOTAL DEPTH **3500**

PRODUCTION

1ST 24 HRS. NAT. _____

1ST 24 HRS. AFTER SHOT _____

GAS _____ CU. FT.

DRY HOLE **✓**

ABANDONED **✓**

DATE

3/21 5

SCOUT