


Section 35 Township 31 Range 4 E

Well No. # 1 Stuckey (A)

Company H & P

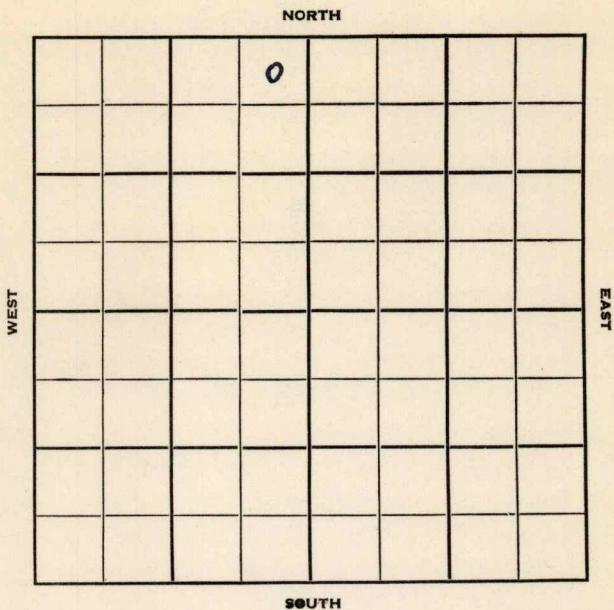

Sec. 35 Twp. 31 R. 4 E

Well No. # 1 Stuckey (A) Farm

H & P Company

Martin & Cash Contractor

Wildcat


330 Ft. from N. Line

_____ Ft. from S. Line

330 Ft. from E. Line

_____ Ft. from W. Line

NE NE NW

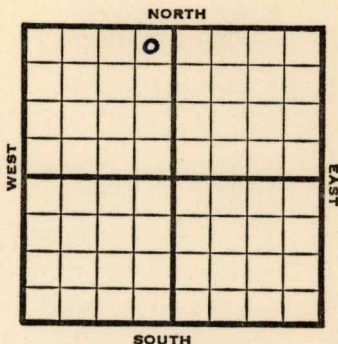

1952

Elev. 1195'

REPORT

8/13

8" @ 101

12/23

Spud 8-12-52 Oil well TD 2956'

8" @ 101 Bart. 2924'

DST 2924-30 open 1/4 hr. rec 6' mud

SSO 550# TD 2930' 5" @ 2930

DD 2956 PB 2938 1 GOPH 3-hydro.

S/5 BO 17 BW 5 hr.

Comp. 2 BOPD

COMPLETED

County Cowley State Kansas

Sec. 35 (Blk. Twp.) 31 (Sur. Rge.) 4E Map No.

Operator H & P

Well No. 1 Farm Stuckey (A)

Elev. _____ Location NE NE NW

		0			

FIRST REPORT

330 Ft. From N Line NW

330 Ft. From E Line Quarter

1st. Report AUG 13 1952

Completion _____

Remarks _____

Martin & Cash - Contr.

Spudding Date _____

Drlg. Data Wildeat

8" @ 101

J. G. McGEHEE

County Cowley State Kansas

Sec. 35 (Blk. 31 (Sur. 4E (Twp. Rge.) Map No.

Operator Helmerich & Payne

Well No. 1 Farm Stuckey "A"

Elev. 1195 Location NE NE NW

		0			

330 Ft. From N Line NW

330 Ft. From E Line Quarter

Ist. Report

Completion DEC 23 1952

Remarks

Martin & Cash - Contr.

Spudding Date 8-12-52

Drlg. Data Oil well TD 2956

8" @ 101 Bart. 2924 DST 2924-30

open 1/4 hr. Rec. 6' mud SSO 550#

TD 2930 5" @ 2930 DD 2956 PB 2938

1 goph 3-hydro. S/ 5 bo 17 bw 5 hr.

Comp. 2 bopd