


Section 36 Township 31 Range 4E

Well No. #1 Holt

Company Renfro Drlg. Co.

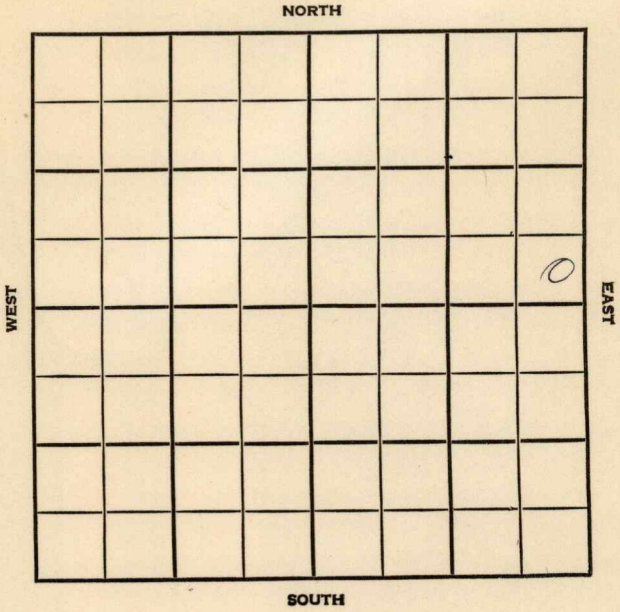

County Cowley Elev. _____
Sec. 36 Twp. 31 Rge. 4E
Company Renfro Drlg. Co.
Farm Name Holt No. 1

TOPS	DEPTH	LOG	DATUM	Loc. in Sec.
Anh.				SE SE NE
T.P.				
H.				
Tr.	btvl	2940		
Dg.				
BL.				
L.		2390		
K.C.	oswego	2630		Geol.
B.K.C.				Contr.
Ce.				Co. Tools
C.		2865		
M.				Pool
M.				Biddle NW
K.				
Mz.				
Me.				
V.				
S.		1859		COMPLETE
S.				NOV 14 '56
A.				
R.				
Pe.				
G.				
TD.				

Date Comm. spd. 11-3-56
8" @ 125 w/100, SJ TOPS, core 2868-95 full
rec, good porosity & fluorescence, DST 2939-
52, 1' rec. 11' SO spked md, BHP 95/20, TD
2980, DST with strat. pkrs 2870-88, 1' rec.
90' O & GCM 420' SW, FP 15-275, BHP 185/20,
D & A COMPLETE

29