


Map No. 2 Sec 6 Twp 20 R. Rice  
Well No. 10 W Farm \_\_\_\_\_ Company \_\_\_\_\_

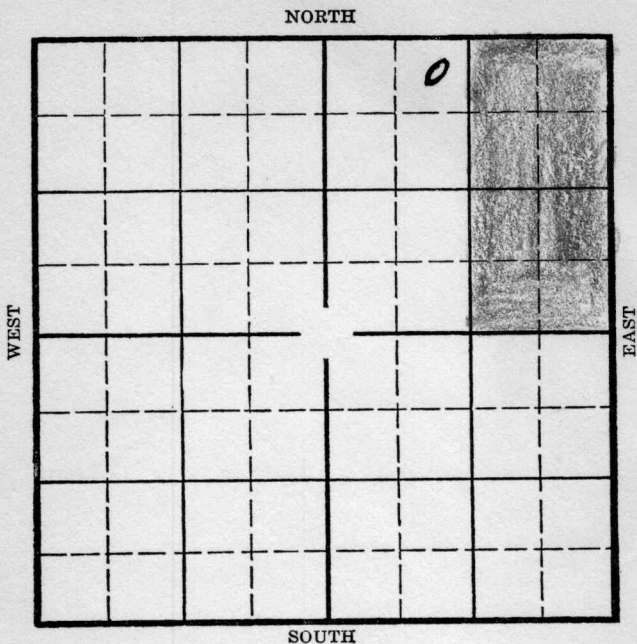

Location \_\_\_\_\_  
Drilling Remarks \_\_\_\_\_

Rig Up \_\_\_\_\_  
Drilling Remarks \_\_\_\_\_

RECORD

Cased \_\_\_\_\_ in. \_\_\_\_\_ ft.  
Sand \_\_\_\_\_  
Gas \_\_\_\_\_  
Oil \_\_\_\_\_  
Total Depth \_\_\_\_\_

PRODUCTION

1st 24 hrs. Nat. \_\_\_\_\_  
1st 24 hrs. after shot \_\_\_\_\_  
Gas \_\_\_\_\_ cu. ft. \_\_\_\_\_  
Dry Hole \_\_\_\_\_  
Abandoned \_\_\_\_\_

Rice  
10W

KANSAS

Map No. \_\_\_\_\_ Sec. 6 Twp. 20 R. 10W

Well No. 2-Specht Farm \_\_\_\_\_

Stanovich Company \_\_\_\_\_


330 Ft. from N. Line

\_\_\_\_\_ Ft. from S. Line

\_\_\_\_\_ Ft. from E. Line

990 Ft. from W. Line

Elev. 1793

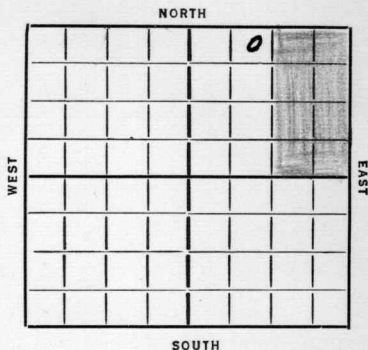

| Date  | REPORT                         |
|-------|--------------------------------|
| 1935  |                                |
| 9/20  | Location                       |
| 10/3  | 13" 198                        |
| 10/10 | Alg 1975                       |
| 10/29 | Top Siliceous lime 3295        |
|       | Alg 3325                       |
|       | Small show Oil (2el)           |
| 11/1  | Alg 3333 500' Oil              |
| 11/7  | TD 3347                        |
|       | 6" 1 1/2 bbls Oil per hr w/sur |
|       | PB 3342                        |
| 11/14 | shot 20 qt 26 bbls per hr      |
|       | 3000 Hyd acid                  |
| 11/21 | pumped 459 bbls 8 hrs &        |
|       | 40 minutes                     |
| 11/22 | pumped 1074 bbls 21 hrs (2el)  |
| 11/27 | Oil 3295                       |
|       | TD 3347                        |
|       | PB 3342                        |
|       | 20 qt shot                     |
|       | 3000 acid                      |
|       | P. 1074 bbls 21 hrs.           |

COMPLETED

Map No. 46 Sec. 6 Twp. 20 R. 10WWell No. 2- SpruittHanbolind Company

Contractor

## FIRST REPORTS

## SECTION PLAT

330 Ft. from N. Line

Ft. from S. Line

Ft. from E. Line

990 Ft. from W. Line

|  |  |   |  |
|--|--|---|--|
|  |  | 0 |  |
|  |  |   |  |
|  |  |   |  |
|  |  |   |  |
|  |  |   |  |

Location offset

Rig up

Drilling and Remarks:

## RECORD

Cased \_\_\_\_\_ in., \_\_\_\_\_ ft.

Sand \_\_\_\_\_

Gas \_\_\_\_\_

Oil \_\_\_\_\_

Total Depth \_\_\_\_\_

## PRODUCTION

1st 24 hrs. Nat. \_\_\_\_\_

1st 24 hrs. after shot \_\_\_\_\_

Gas \_\_\_\_\_ Cu. Ft.

Dry Hole \_\_\_\_\_

Abandoned \_\_\_\_\_

Date

9-20-35 192

ORVAL MANNSCHRECK

Scout

KANSAS

Map No. 46 Sec. 6 Twp. 20 R. 10WWell No. 2-SpechtStanolind Oil & Gas Company

Contractor

offset

## SECTION PLAT

|  |  |  |  |
|--|--|--|--|
|  |  |  |  |
|  |  |  |  |
|  |  |  |  |
|  |  |  |  |
|  |  |  |  |

230 Ft. from N. Line

Ft. from S. Line

Ft. from E. Line

990 Ft. from W. Line

COMPLETE

Location

Rig up

Drilling and Remarks:

P.B. 3342  
20 qt. shot.  
3000 acid

P. 1074 bbls  
21 hrs.

## RECORD

Cased \_\_\_\_\_ in., \_\_\_\_\_ ft.

Sand Sil 3295

Gas \_\_\_\_\_

Oil \_\_\_\_\_

Total Depth 3347

## PRODUCTION

1st 24 hrs. Nat. \_\_\_\_\_

1st 24 hrs. after shot \_\_\_\_\_

Gas \_\_\_\_\_ Cu. Ft.

Dry Hole \_\_\_\_\_

Abandoned \_\_\_\_\_

Date

11-27-25 192

ORVAL MANNSCHRECK

Scout