

Barton

KANSAS

Section 14 Township 18 Range 11WWell No. #1 RoeslerCompany Bishop Oil Company

NORTH

WEST

EAST

		0					


SOUTH

Barton

KANSAS ✓

Sec. 14 Twp. 18 R. 11 WWell No. # 1 Roesler FarmBishop Oil Co. CompanyTodd Drlg. ContractorRoesler Pool330 Ft. from N. Line Ft. from S. Line990 Ft. from E. Line Ft. from W. Line

NW NE SW

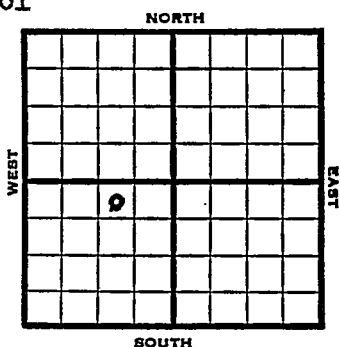

1953

Elev. 1779' REPORT

2/11

Spud 2-5-53
 8" @ 228 Anhy 560'
 Drlg. 1944'


2/19

TD 3340' D & A

2/25

Spud 2-5-53 D & A TD 3325
 8" @ 228 Anhy 560 Heeb 2884
 Br lime 2999 Lans 3014 Cong 3288
 TD 3325
 D & A

ABANDONED

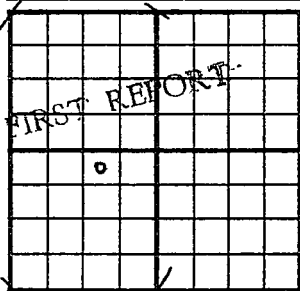County Barton State KansasSec. 14 (Blk. Twp.) 18 (Sur. Rge.) 11W Map No. _____Operator Bishop Oil Co.Well No. 1 Farm RoeslerElev. _____ Location NW NE SW330 Ft. From N Line SW990 Ft. From E Line Quarter1st. Report FEB 11 1953CompletionRemarksTodd Drlg. - Contr.Spudding Date 2-5-53Drlg. Data Roesler Pool8" @ 228 Anhy 560 drlg. 1944

J. G. McGEHEE