

KANSAS

FORM 51 5M 10-41 PETROL


Cowley

Section 35 Township 31 Range 4-E

Well No. #1 McKnab

Company Summit Drilling

Wildcat

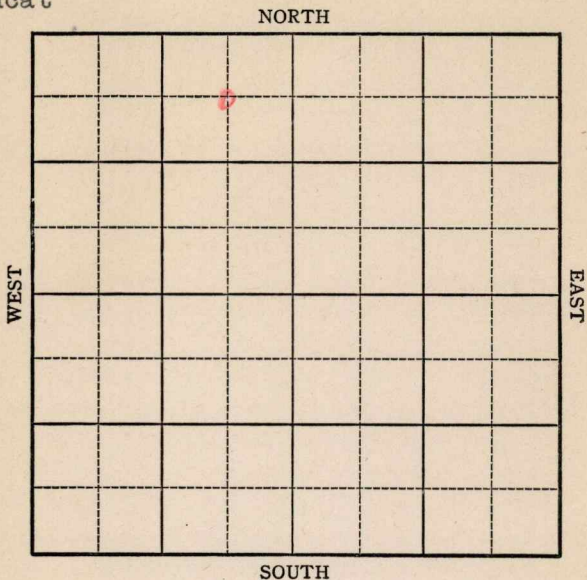

Sec. 35 Twp. 31 R. 4E

Well No. 1-McKnab Farm


Summit Drilling Company
(Wildcat)

660 Ft. from N. Line

Ft. from S. Line

660 Ft. from E. Line

Ft. from W. Line

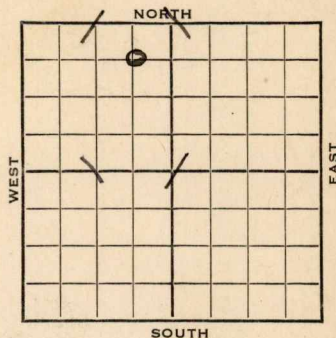

C NE NW

1206

1942

Elev 1206

REPORT

9/23

Location

9/30

TD 110 10" - 82"

10/7

KE 2310 Drlg. 2690

10/14

" "

10/21

Bart 2943 7" @ 2950-15 qts 2945-60
no shows; **Miss 2975** Drlg 3036

10/28

Drlg 3217

11/4

Arb 3424'

no shows, TD 3455'

ABANDONED

KANSAS

Map No. 2 Sec. 35 Twp. 31 R. 4EWell No. 1 McKnab

Summit Drilling

Company

FIRST REPORT

Contractor

C NE NW

SECTION PLAT


660 Ft. from N. Line

Ft. from S. Line

660 Ft. from E. Line

Ft. from W. Line

WILDCAT

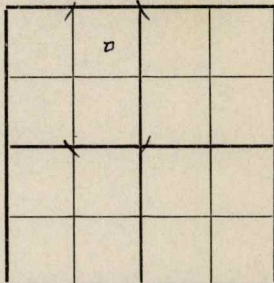Location XXX

RECORD

Rig up

Drilling and Remarks:

Cased _____ in., _____ ft.

Sand _____

Gas _____

Oil _____

Total Depth _____

PRODUCTION

1st 24 hrs. Nat. _____

1st 24 hrs: after shot _____

Gas _____ Cu. Ft.

Dry Hole _____

Abandoned _____

Date

SEP 23 1942

19

S. J. LEWIS

Scout

Map No. 2 Sec. 35 Twp. 31 R. 4E

Well No. 1 McKnab

Summit Drilling Company

ABANDONED Contractor

C NE NW

660 Ft. from N. Line

 Ft. from S. Line

660 Ft. from E. Line

 Ft. from W. Line

SECTION PLAT

	6		

WILDCAT

Location

Rig up

Drilling and Remarks:

Cor 83424

No show

RECORD

Cased in., ft.

Sand

Gas

Oil

Total Depth 3455

PRODUCTION

1st 24 hrs. Nat.

1st 24 hrs. after shot

Gas Cu. Ft.

Dry Hole

Abandoned

Date

NOV 4 1942 19

S. J. LEWIS Scout