


Form 51-5M-3-35-Mid-West

Map No. KANSAS Sec. 6 Twp. 20 R. 10-WWell No. #3 Specht Farm
Stanolind O & G Company

NORTH

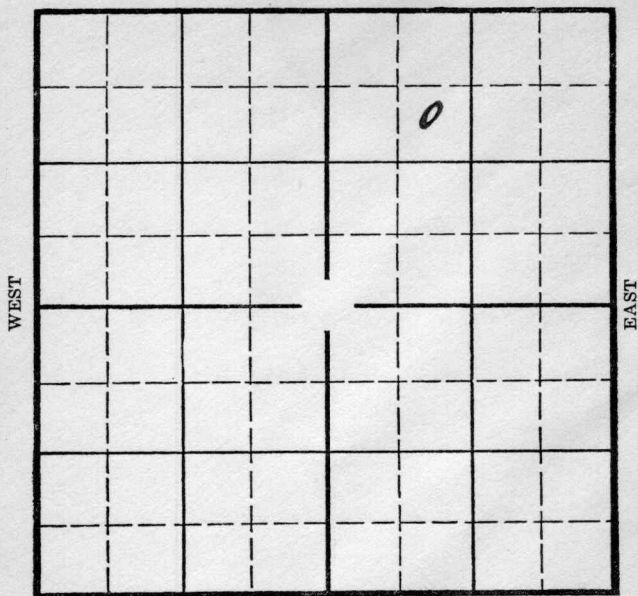

OFFSET

SOUTH

Location _____

Drilling Remarks _____

Rig Up _____

Drilling Remarks _____

RECORD

Cased _____ in. _____ ft.

Sand _____

Gas _____

Oil _____

Total Depth _____

PRODUCTION

1st 24 hrs. Nat. _____

1st 24 hrs. after shot _____

Gas _____ cu. ft. _____


Dry Hole _____

Abandoned _____

Map No. _____ Sec. 6 Twp. 20 R. 10W
Well No. 3- Specht Farm _____
Stanolind Oil Co Company _____

990 Ft. from N. Line
____ Ft. from S. Line
____ Ft. from E. Line
990 Ft. from W. Line

Elev. 1793

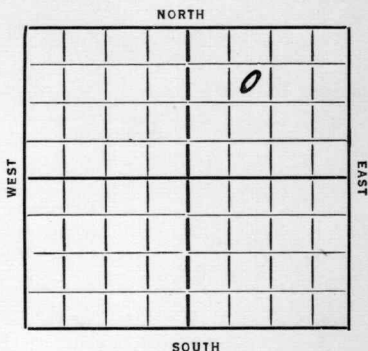

REPORT

~~2/12~~
2/12 Location
2/21 Allen & Mat
2/28
3/6 slg 1130 12" 219
3/13 " 3220 (Gel)
~~3/17~~
3/20 T Sil 3295 7" 3290
T.D. 3300 WOC
3/26 Potentially 1739 Bbls Oil
Natural (Gel)
4/2
4/1 Sil 3295
T.D. 3311
1739 Bbls Oil

COMPLETED

KANSAS

Map No. 46 Sec. 6 Twp. 20 R. 10W

Well No. 3- Specht

Stanolind Oil Company

Contractor

FIRST REPORTS

SECTION PLAT

990 Ft. from N. Line

_____ Ft. from S. Line

_____ Ft. from E. Line

990 Ft. from W. Line

offset

		0	

Location ☒

Rig up ☐

Drilling and Remarks:

RECORD

Cased _____ in., _____ ft.

Sand _____

Gas _____

Oil _____

Total Depth _____

PRODUCTION

1st 24 hrs. Nat. _____

1st 24 hrs. after shot _____

Gas _____ Cu. Ft.

Dry Hole _____

Abandoned _____

Date

2-12-36 192 _____ Scout

ORVAL MANNSCHRECK

Map No. 46 Sec. 6 Twp. 20 R. 10WWell No. 3-SprightStanolind Oil & Gas Company

Contractor

COMPLETE

990 Ft. from N. Line

Ft. from S. Line

Ft. from E. Line

990 Ft. from W. Line

SECTION PLAT

		0	

Location

Rig up

Drilling and Remarks:

1739 bbls

RECORD

Cased _____ in., _____ ft.

Sand Nil 3295

Gas _____

Oil _____

Total Depth 3311

PRODUCTION

1st 24 hrs. Nat. _____

1st 24 hrs. after shot _____

Gas _____ Cu. Ft.

Dry Hole _____

Abandoned _____

ORVAL MANNSCHRECK

Date

4-1-36 192 _____ Scout