


Section 14 Township 18 Range 11-W

Well No. #2 Rossler

Company Flerney & Williams
Roesler Pool

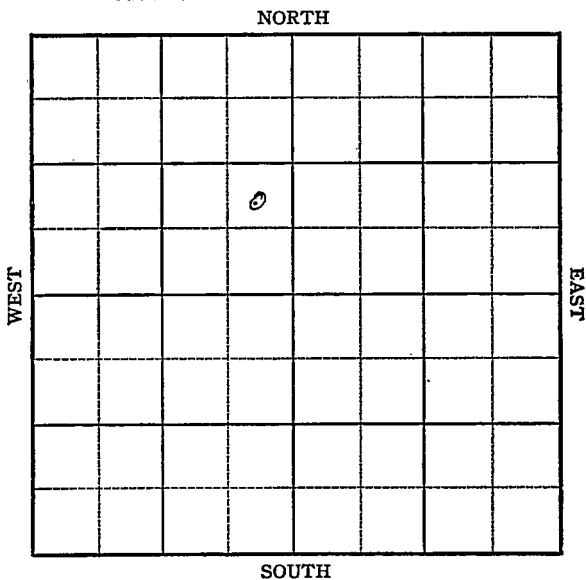

Sec. 14 Twp. 18 R. 11W

Well No. #2 Roesler Farm

Florney & Williams

Company

Florney & Williams

Contractor

Roesler Pool


_____ Ft. from N. Line

990' Ft. from S. Line

330' Ft. from E. Line

_____ Ft. from W. Line

NE SE NW

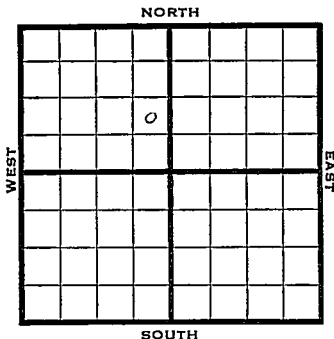

1949

Elev 1787'

REPORT

10/26

8" @ 575'

Anhy 572'

Drlg. 1430'

11/2

TD 3312'

Lansing 3015'

Cong 3288'

Arb. 3301'

Aband.

ABANDONED

Map No. _____ Sec. 14 Twp. 18 R. 11W

Well No. 2 Roesler

Florney & Williams Company

Florney & Williams Contractor

NE SE NW

FIRST REPORT
SECTION PLAT

_____ Ft. from N. Line

990 Ft. from S. Line

330 Ft. from E. Line

_____ Ft. from W. Line

	6		

Barton County

Location _____

Rig up _____

Drilling and Remarks:

8" @ 575

Anhy 572

dr lg. 1430

RECORD

Cased _____ in., _____ ft.

Sand _____

Gas _____

Oil _____

Total Depth _____

PRODUCTION

1st 24 hrs. Nat. _____

1st 24 hrs. after shot _____

Gas _____ Cu. Ft.

Dry Hole _____

Abandoned _____

Date

OCT 26 1949 19

S. J. LEWIS Scout

Map No. _____ Sec. 14 Twp. 18 R. 11W

Well No. 2 Roesler

Florney & Williams Company

ABANDONED

Contractor

NE SE NW

E11782
SECTION PLAT

_____ Ft. from N. Line

990 Ft. from S. Line

330 Ft. from E. Line

_____ Ft. from W. Line

	o		

Barton County

Location _____

Rig up _____

Drilling and Remarks:

Home 3015
Comp 3258
Out 3301

RECORD

Cased _____ in., _____ ft.

Sand _____

Gas _____

Oil _____

Total Depth 3312

PRODUCTION

1st 24 hrs. Nat. _____

1st 24 hrs. after shot _____

Gas _____ Cu. Ft.

Dry Hole _____

Abandoned _____

Date

NOV 2 1949 19

S. J. LEWIS Scout