

KANSAS


Cowley

FORM 51 5M 1-42 PETROL

Section 35 Township 31 Range 4-E

Well No. #1 McKnabb

Company E. Adams

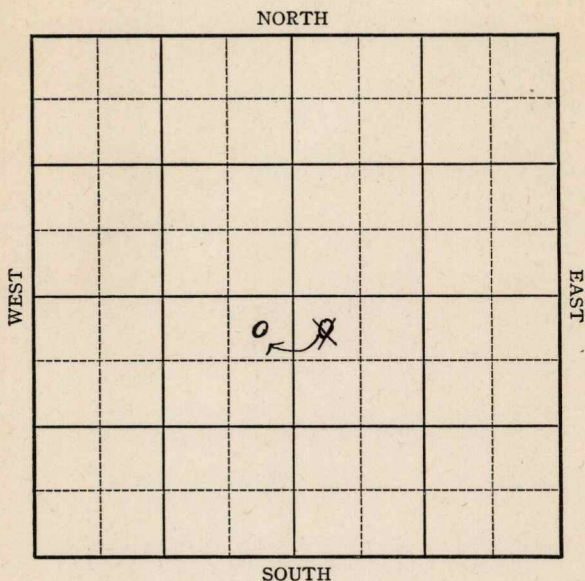

KANSAS

Cowley

Sec. 35 Twp. 31 R. 4-E

Well No #1 McKnabb Farm

E. Adams Company

Miscellaneous


330 Ft. from N. Line

 Ft. from S. Line

330 Ft. from E. Line

330 Ft. from W. Line

Elev. 1170

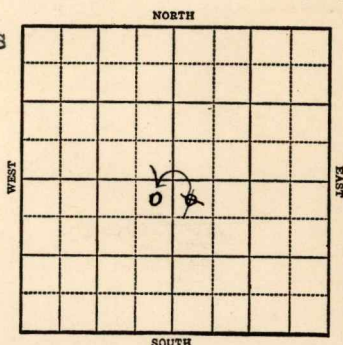

1943

R E P O R T

5/26 Location.

6/2 Rotary

6/9 . 10" @ 66'
Drlg. 420'

6/16 *335* K.C. 2365
Drlg. 2485'

6/23 Bart. zone 2913
7" @ 2913
T.D. 2956'

6/30 Layton 2270

Miss. 2956
T.D. 2956'

ABANDONED

Cowley

KANSAS

Map No. 2 Sec. 35 Twp. 31 R. 4EWell No. 1 McKnabbE. Adams

Company

FIRST REPORT

Contractor

NW SE

SECTION PLAT

330 Ft. from N. Line Ft. from S. Line Ft. from E. Line330 Ft. from W. Line

		6	

MISCELLANEOUS

Location XXXRig up

Drilling and Remarks:

RECORD

Cased in., ft.Sand Gas Oil Total Depth

PRODUCTION

1st 24 hrs. Nat. 1st 24 hrs. after shot Gas Cu. Ft.Dry Hole Abandoned

Date

MAY 26 1943

19

S. J. LEWIS Scout

Cowley

KANSAS

Map No. 2 Sec. 35 Twp. 31 R. 4EWell No. 1 McKnabb

E. Adams

Company

CORRECTION

Contractor

NE SW


SECTION PLAT

330 Ft. from N. Line

Ft. from S. Line

330 Ft. from E. Line

Ft. from W. Line

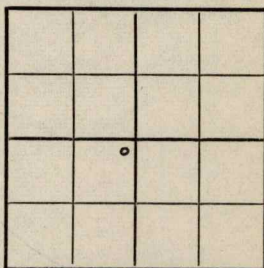

MISCELLANEOUS

Location

Rig up

Drilling and Remarks:

Reported

NW SE

RECORD

Cased _____ in., _____ ft.

Sand _____

Gas _____

Oil _____

Total Depth _____

PRODUCTION

1st 24 hrs. Nat. _____

1st 24 hrs. after shot _____

Gas _____

Cu. Ft.

Dry Hole _____

Abandoned _____

Date

JUN 9 1943 19

S. J. LEWIS

Scout

KANSAS

Cowley

Map No. 2 Sec. 35 Twp. 31 R. 4EWell No. 1 McKnabbE. Adams


Company

ABANDONED

Contractor

NE SW

SECTION PLAT

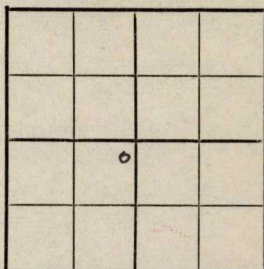330 Ft. from N. Line Ft. from S. Line330 Ft. from E. Line Ft. from W. Line

MISCELLANEOUS

Location Rig up

Drilling and Remarks:

Hay ton 2270Miss 2956

RECORD

Cased in., ft.Sand Gas Oil Total Depth 2956

PRODUCTION

1st 24 hrs. Nat. 1st 24 hrs. after shot Gas Cu. Ft.Dry Hole Abandoned

Date

JUN 30 1943 19S. J. LEWIS Scout