


Cowley

KANSAS

SECTION 36 TOWNSHIP 31S RANGE # 4E

WELL NO. #1 Smith

COMPANY Stewart Oil

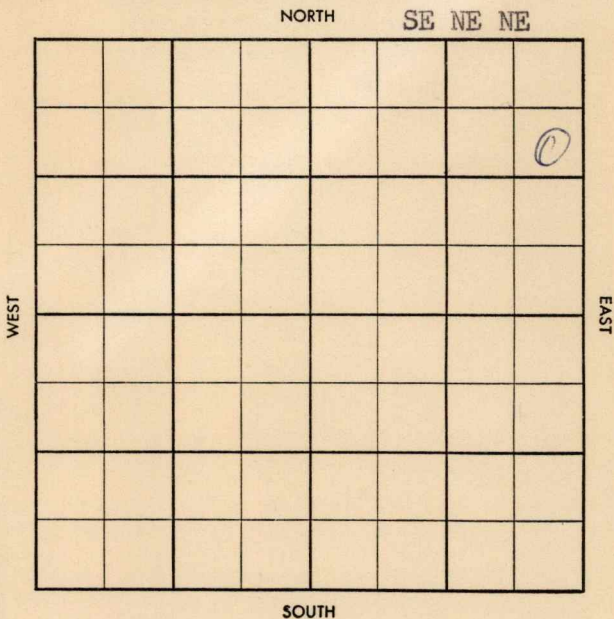

CO. ~~Cowley~~ ELEV 1340
SEC. 36 TWP. 31 RGE. 4E
COMPANY Stewart Oil NO. 1

NOV 20 '57
COMPLETE
CSO DITM

FARM Smith
LOC. SE. NE

Stal	1867
Lay	2294
Lay	2373
ke	2400
BKC	2541
FTscott	2699
ce	2770
Cattled	2882
Baxsd	2938
c	3027

GEOL. _____
CONTR. White & Ellis
POOL NW Biddle
SPUD 10-15-57
M I R OCT 23 '57
8" 210' DST
2296-2305 60"
7' M BHP 48/20"
crd 2879-2907
na 23 1/2' DST

2882-74 90" 186' 0cm
130' SW FP 32-130 BHP
848 OCT 30 '57 DST 2874-85 3 hrs
6/2 hrs 40" no ga no rec
BHP 49 1/2" MISS 3035
M Li 3043 RTD 3077
5" 2930/200 NOV 6 '57 co
24/ 2877-83 190 1 gw ph 8 go
16 gw ph dock SQ frac
NOV 20 '57 NOV 20 '57 20 1 25 go

25 Bo pd + 50 Bw

cattlemen

CO
LSE
NO.
SEC.
TWP.
RGE.

