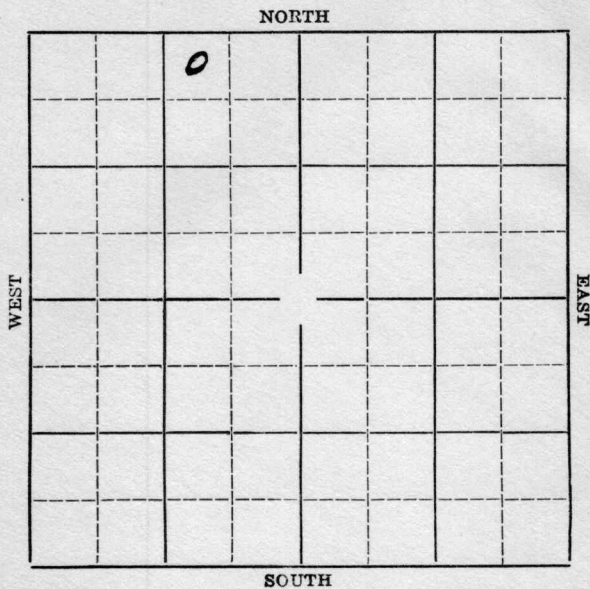


Section 6 Township 20 Range 10-WWell Number 6-BerscheidtCompany Tatlock et al

Rice

Map No. KANSAS Sec. 6 Twp. 20 R. 10W

Well No. #6 Berscheidt Farm

Tattlock et al Company


330' Ft. from N. Line

 Ft. from S. Line

990' Ft. from E. Line

 Ft. from W. Line

Elev. 1775

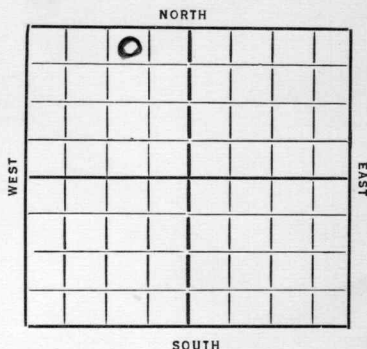

Date 1936

REPORT

6/17 Rig on ground.

6/25 Rigging up.

7/2 Drlg. 1130'.

7/9 Drlg. 2430'1

7/16 Sil. 3269'. Run 7". Rust.

7/23 --

7/30 TD 3286'. 2800' oil in hole.

8/5/36-Sil. 3269'.

T.D. 3286'.

2000 gallons of acid.

potential 1331 bbls in 21 hours.

COMPLETED

Rice
 Map No. 46 **KANSAS** Sec. 6 Twp. 20 R. 10 W

Well No. 6 Berscheidt

Matlock & Dal Company

Contractor

SECTION PLAT

330 Ft. from N. Line

_____ Ft. from S. Line

990 Ft. from E. Line

_____ Ft. from W. Line

FIRST REPORT

	0		

Location _____

Rig up _____

Drilling and Remarks:

ROG

RECORD

Cased _____ in., _____ ft.

Sand _____

Gas _____

Oil _____

Total Depth _____

PRODUCTION

1st 24 hrs. Nat. _____

1st 24 hrs. after shot _____

Gas _____ Cu. Ft.

Dry Hole _____

Abandoned _____

Date

JUN 17 1936 19

S. J. LEWIS Scout

KANSAS

Map No. 46 Sec. 6 Twp. 20 R. 10W.Well No. 6 BerschmidtTatlock & Co Company

Contractor

SECTION PLAT

	0		

380 Ft. from N. Line

_____ Ft. from S. Line

990 Ft. from E. Line

_____ Ft. from W. Line

COMPLETED

Location _____

Rig up _____

Drilling and Remarks:

Oil 32692000 acidPa 8133121 hrs.

RECORD

Cased _____ in., _____ ft.

Sand _____

Gas _____

Oil _____

Total Depth 8286

PRODUCTION

1st 24 hrs. Nat. _____

1st 24 hrs. after shot _____

Gas _____ Cu. Ft.

Dry Hole _____

Abandoned _____

Date

AUG 5 1936 19

S. J. LEWIS Scout